SURVEY & REMONUMENTATION

NOV 25 1998

SECTION

Approved By Delta County Land Survey Remonumentation Peer Group Under Act 345 Of P.A. Of 1990 On Oct 29, 1998
Robert Schmeling
Acting Chairman

LAND CORNER RECORDATION CERTIFICATE

Filing Requirement of Act 74, Mich. P.A. 1970

For corners in DELTA (County)

	Located In:	Corner Code ##
1. Public Land Survey	T 38 N R 22 W	K-1 & L-1
	T ___ R ___	
	T 39 N R 22 W	K-13 & L-13
	T ___ R ___	
2. Property Controlling	S ___ T ___ R ___	
in Section	S ___ T ___ R ___	
3. Miscellaneous	S ___ T ___ R ___	
Property in Sec.	S ___ T ___ R ___	

Recorded Nov 5 1998
at 9:00 o'clock AM
Liber 9 Page 104
William C. Thomas
Delta County, MI Reg. of Deeds

Register of Deeds Stamp & File Number

4. Lot No. _____, Recorded Plat _____
5. Private Claims _____

K-1 [NW COR SEC 1] & L-1 [N 1/4 COR SEC 1]
K-13 [SE COR SEC 35 T39NR22W] & L-13 [S1/4 COR SEC 36 T39NR22W]

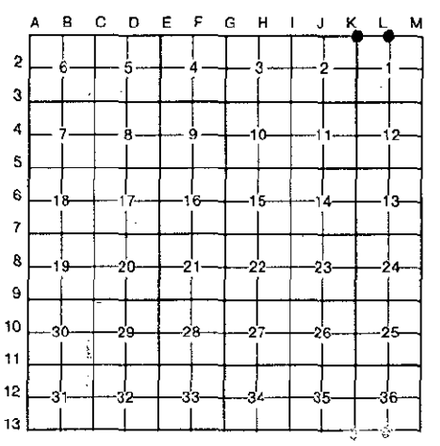

I, M.P. DAVIS, in a field survey on JULY, 1998, do hereby certify that under requirements of P.A. 74, Michigan P.A. of 1970, the corner points mentioned in lines 1 and 2 above were in conformance with regulations and rules therefore as required in the current manual of survey instructions of the United States Department of the Interior, Bureau of Land Management or by a decree of a Court of Law and/or that the corner points mentioned in lines 3, 4 and 5 above were in conformance with the rules of the Michigan Board of Land Surveyors or by a Decree of a Court of Law; established, re-established, monumented, re-monumented, recovered, found as expressed below:

NOTE: Not more than 4 corners, all in the same town and range, may be recorded on this certificate.

A. Description of original monument and accessories and/or subsequent restoration:

K-1 [NW COR SEC 1] JOHN BURT, D.S. - 1845 - (YELLOW BIRCH 14" N12°E 1.02 LINKS) (FIR 7" N56°W 15 LINKS)
M.S. McNABB - 1933 - CORNER IN PLACE - SET IRON PIPE (NO WITNESSES)

L-1 [N 1/4 COR SEC 1] JOHN BURT, D.S. - 1845 - (TAMARACK 7" 1/4 SEC COR) (TAMARACK 3" N12°E 7 LINKS)
D.A. BROTHERTON - 1909 - FOUND ORIGINAL COR (CEDAR BT STAKE N45°W 26.5') (CEDAR BT STAKE S45°E 22.6')

B. Description of corner evidence found and/or method applied in restoring or reestablishing corner:

K-1 [NW COR SEC 1] ID McNABB'S IRON PIPE BY 1933 ROAD ALIGNMENT SURVEY OF COUNTY ROAD 513. ACCEPTED THIS COR AS THE BEST AVAILABLE EVIDENCE AS TO THE POSITION OF THE ORIGINAL CORNER.

L-1 [N 1/4 COR SEC 1] FOUND 1" SQUARE BOLT AT INTERSECTIONS OF ROADS EAST/WEST & NORTH/SOUTH. MATCHED BROTHERTON'S RECORD DISTANCE SOUTH TO S 1/4 COR SEC 1. ACCEPTED THIS CORNER AS A CAREFUL AND FAITHFUL PERPETUATION OF THE ORIGINAL CORNER.

C. Description of monument for corner and accessories established to perpetuate locating the position of the corner:

K-1 SET, IN MON BOX, 5/8" x 18" REBAR W/A 3 1/4" AL. CAP STAMPED TO ID CORNER POSITION.

SURVEY MONUMENT SIGN POST	WITNESS BOLT	P. POLE	WITNESS BOLT
S68°W	N44°W	N54°E	S44°E
47.91' (TO FACE)	100.00'	52.00'	100.00'

L-1 SET, 6" BELOW SURFACE, 5/8" x 18" REBAR W/A 3 1/4" AL. CAP STAMPED TO ID CORNER POSITION.

STOP SIGN	P. POLE	5" ASH	FENCE CORNER
N24°W	N31°W	S19°W	N24°E
31.11 (TO FACE)	38.38'	39.83'	33.00'

STATE OF MICHIGAN
M. P. DAVIS
LAND SURVEYOR
NO. 16926
REGISTERED LAND SURVEYOR

NOTE: BEARINGS TO REFERENCE OBJECTS ARE MAGNETIC & DISTANCES ARE TO A NAIL WITH REFERENCE TAG IN OBJECT, UNLESS OTHERWISE NOTED.

Signed by M.P. Davis Date 11/3/98

Surveyor's Michigan License No. 16926

LIBER 0009 PAGE 104

FORM APPROVED BY MICHIGAN STATE BOARD OF LAND SURVEYORS, JAN. 28, 1971
REVISED MAY 14, 1975
REVISED JAN., 1983