

SURVEY & REMONUMENTATION

NOV 25 1998

LAND CORNER RECORDATION CERTIFICATE
 Filing Requirement of Act 74, Mich. P.A. 1970

Approved By Delta County
 Land Survey Remonumentation
 Peer Group Under Act 345 Of
 P.A. Of 1990 On Oct 29, 1998
Walter C. Thoman
 Acting Chairman

SECTION

For corners in

DELTA
 (County)

Located In:

Corner Code #

- | | | |
|------------------------------------|-----------------------------|-------------------------|
| 1. Public Land Survey | T <u>38</u> N R <u>22</u> W | <u>K-4</u> & <u>L-3</u> |
| | T _____ R _____ | _____ |
| | T _____ R _____ | _____ |
| | T _____ R _____ | _____ |
| 2. Property Controlling in Section | S _____ T _____ R _____ | _____ |
| | S _____ T _____ R _____ | _____ |
| 3. Miscellaneous Property in Sec. | S _____ T _____ R _____ | _____ |
| | S _____ T _____ R _____ | _____ |

Recorded Nov 5 1998
 at 9:00 o'clock AM
 Liber 9 Page 103
Walter C. Thoman
 Delta County, MI Reg. of Deeds

Register of Deeds Stamp & File Number

4. Lot No. _____, Recorded Plat _____
 5. Private Claims K-4 [E 1/4 COR SEC 11] & L-3 [S 1/4 COR SEC 1]

A	B	C	D	E	F	G	H	I	J	K	L	M
2	6	5	4	3	2	1						
3												
4	7	8	9	10	11	12						
5												
6	18	17	16	15	14	13						
7												
8	19	20	21	22	23	24						
9												
10	30	29	28	27	26	25						
11												
12	31	32	33	34	35	36						
13												

I, M.P. DAVIS, in a field survey on JULY, 19 98, do hereby certify that under requirements of P.A. 74, Michigan P.A. of 1970, the corner points mentioned in lines 1 and 2 above were in conformance with regulations and rules therefore as required in the current manual of survey instructions of the United States Department of the Interior, Bureau of Land Management or by a decree of a Court of Law and/or that the corner points mentioned in lines 3, 4 and 5 above were in conformance with the rules of the Michigan Board of Land Surveyors or by a Decree of a Court of Law; established, re-established, monumented, re-monumented, recovered, found as expressed below:

NOTE: Not more than 4 corners, all in the same town and range, may be recorded on this certificate.

A. Description of original monument and accessories and/or subsequent restoration:

- K-4 [E 1/4 COR SEC 11] A. MERRYWEATHER, D.S.- 1846 - CEDAR 3" CORNER TREE (TAMARACK 10" S2W 25 LINKS) (TAMARACK 4" N22E 7 LINKS) NO RECORD EVIDENCE OF SUBSEQUENT CORNER RECOVERY AND/OR MONUMENTATION**
- L-3 [S 1/4 COR SEC 1] A. MERRYWEATHER, D.S.- 1846 - WOOD POST (CEDAR 8" N80E- 18 LINKS) (HEMLOCK 7"-S49W 9 LINKS) D.A. BROTHERTON - 1909 - ID CORNER POSITION FROM STAKE IN PLACE & BOTH ORIGINALS, SET (CEDAR BT STAKE N36°42'W 28') (CEDAR BT STAKE S36°42'E 21.5')**

B. Description of corner evidence found and/or method applied in restoring or reestablishing corner:

K-4 [E 1/4 COR SEC 11] SET AT REMAINS OF WOOD POST, ALSO FOUND OLD BT STAKE FACING AT CORNER (N3°E 18.1') IN A DECAYED 16" ± STUMP. MATCHES WELL WITH TIE TO PLAT OF SKAUG BROTHERS NO.#1. ACCEPTED THIS CORNER AS THE BEST AVAILABLE EVIDENCE OF THE POSITION OF THE ORIGINAL CORNER.

L-3 [S 1/4 COR SEC 1] NO EVIDENCE OF COR. FOUND. REESTABLISHED CORNER POSITION AT CENTERLINE ROAD INTERSECTION EAST/WEST & NORTH. MATCHED BROTHERTON'S RECORD DISTANCE NORTH TO N1/4 COR SEC. 1. ACCEPTED THIS LOCATION AS THE BEST AVAILABLE EVIDENCE OF THE POSITION OF THE ORIGINAL CORNER.


C. Description of monument for corner and accessories established to perpetuate locating the position of the corner:

K-4 SET BERNTSEN AL MONUMENT WITH CAP STAMPED TO ID THE COR. POSITION.

SURVEY MONUMENT SIGN POST	CEDAR 7"	CEDAR 4"	CEDAR 11"	CEDAR 7"
SOUTH	N32°W	S54°W	S73°E	N60°E
1.65 (TO FACE)	7.67'	22.96'	25.18'	28.72'

L-3 SET, 6" BELOW SURFACE, A 5/8" X 18" REBAR W/A 3 1/4 " AL. CAP STAMPED TO ID COR POSITION.

SURVEY MONUMENT SIGN POST	P. POLE	STOP SIGN
SOUTH	S36°W	N27°W
20.74' (TO FACE)	35.52'	34.70'

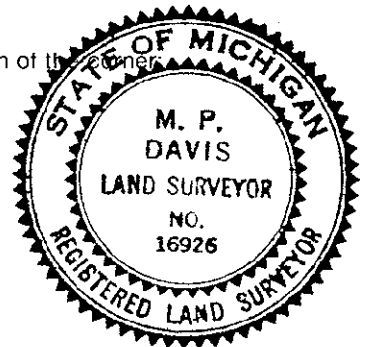

NOTE: BEARINGS TO REFERENCE OBJECTS ARE MAGNETIC & DISTANCES ARE TO A NAIL WITH REFERENCE TAG IN OBJECT, UNLESS OTHERWISE NOTED.

Signed by M.P. Davis Date 11/3/98

Surveyor's Michigan License No. 16926