

SURVEY & REMONUMENTATION

NOV 25 1998

SECTION

LAND CORNER RECORDATION CERTIFICATE
Filing Requirement of Act 74, Mich. P.A. 1970

Approved By Delta County
 Land Survey Remonumentation
 Peer Group Under Act 345 Of
 P.A. Of 1990 On Oct 29, 1998

Phyllis L. ...
 Acting Chairman

For corners in
DELTA
 (County)

Located In: Corner Code #

- 1. Public Land Survey T 38 N R 22 W K-1 & L-1
 T _____ R _____
 T 39 N R 22 W K-13 & L-13
 T _____ R _____
- 2. Property Controlling S _____ T _____ R _____
 in Section S _____ T _____ R _____
- 3. Miscellaneous S _____ T _____ R _____
 Property in Sec. S _____ T _____ R _____

Recorded Nov 5 1998
 at 9:00 o'clock AM
 Liber 9 Page 104
William C. Thomas
 Delta County, MI Reg. of Deeds

Register of Deeds Stamp & File Number

- 4. Lot No. _____, Recorded Plat _____
- 5. Private Claims K-1 [NW COR SEC 1] & L-1 [N 1/4 COR SEC 1]
K-13 [SE COR SEC 35 T39NR22W] & L-13 [S1/4 COR SEC 36 T39NR22W]

A	B	C	D	E	F	G	H	I	J	K	L	M
2	6	5	4	3	2	1						
3												
4	7	8	9	10	11	12						
5												
6	18	17	16	15	14	13						
7												
8	19	20	21	22	23	24						
9												
10	30	29	28	27	26	25						
11												
12	31	32	33	34	35	36						
13												


I, M.P. DAVIS, in a field survey on JULY, 1998, do hereby certify that under requirements of P.A. 74, Michigan P.A. of 1970, the corner points mentioned in lines 1 and 2 above were in conformance with regulations and rules therefore as required in the current manual of survey instructions of the United States Department of the Interior, Bureau of Land Management or by a decree of a Court of Law and/or that the corner points mentioned in lines 3, 4 and 5 above were in conformance with the rules of the Michigan Board of Land Surveyors or by a Decree of a Court of Law; established, re-established, monumented, re-monumented, recovered, found as expressed below:

NOTE: Not more than 4 corners, all in the same town and range, may be recorded on this certificate.

- A. Description of original monument and accessories and/or subsequent restoration:
 K-1 [NW COR SEC 1] JOHN BURT, D.S. - 1845 - (YELLOW BIRCH 14" N12°E 1.02 LINKS) (FIR 7" N56°W 15 LINKS)
 M.S. McNABB - 1933 - CORNER IN PLACE - SET IRON PIPE (NO WITNESSES)
- L-1 [N 1/4 COR SEC 1] JOHN BURT, D.S. - 1845 - (TAMARACK 7' 1/4 SEC COR) (TAMARACK 3" N12°E 7 LINKS)
 D.A. BROTHERTON - 1909 - FOUND ORIGINAL COR (CEDAR BT STAKE N45°W 26.5') (CEDAR BT STAKE S45°E 22.6')

- B. Description of corner evidence found and/or method applied in restoring or reestablishing corner:
 K-1 [NW COR SEC 1] ID McNABB'S IRON PIPE BY 1933 ROAD ALIGNMENT SURVEY OF COUNTY ROAD 513. ACCEPTED THIS COR AS THE BEST AVAILABLE EVIDENCE AS TO THE POSITION OF THE ORIGINAL CORNER.
- L-1 [N 1/4 COR SEC 1] FOUND 1" SQUARE BOLT AT INTERSECTIONS OF ROADS EAST/WEST & NORTH/SOUTH. MATCHED BROTHERTON'S RECORD DISTANCE SOUTH TO S 1/4 COR SEC 1. ACCEPTED THIS CORNER AS A CAREFUL AND FAITHFUL PERPETUATION OF THE ORIGINAL CORNER.

- C. Description of monument for corner and accessories established to perpetuate locating the position of the corner:
- K-1 SET, IN MON BOX, 5/8" x 18" REBAR W/A 3 1/4" AL. CAP STAMPED TO ID CORNER POSITION.
 SURVEY MONUMENT SIGN POST WITNESS BOLT P. POLE WITNESS BOLT
 S68°W N44°W N54°E S44°E
 47.91' (TO FACE) 100.00' 52.00' 100.00'
- L-1 SET, 6" BELOW SURFACE, 5/8" x 18" REBAR W/A 3 1/4" AL. CAP STAMPED TO ID CORNER POSITION.
 STOP SIGN P. POLE 5" ASH FENCE CORNER
 N24°W N31°W S19°W N24°E
 31.11 (TO FACE) 38.38' 39.83' 33.00'

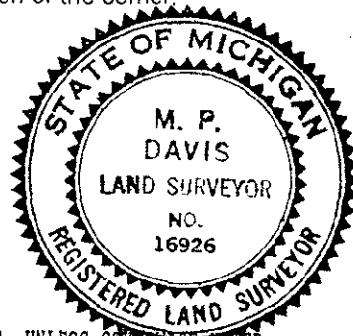

NOTE: BEARINGS TO REFERENCE OBJECTS ARE MAGNETIC & DISTANCES ARE TO A NAIL WITH REFERENCE TAG IN OBJECT, UNLESS OTHERWISE NOTED.

Signed by M.P. Davis Date 11/3/98
 Surveyor's Michigan License No. 16926