

**SURVEY &  
REMONUMENTATION**

AUG 20 1996

**COMMISSION**

Approved By Delta County  
Land Survey Remonumentation  
Peer Group Under Act 345 Of  
P.A. Of 1990 On June 27, 1996

**LAND CORNER RECORDATION CERTIFICATE**  
Filing Requirement of Act 74, Mich. P.A. 1970

*Phyllis R. Melnick*  
acting Chairman

For corners in  
DELTA  
(County)

Located In: \_\_\_\_\_ Corner Code ## \_\_\_\_\_

1. Public Land Survey	T <u>38 N</u> R <u>23 W</u>	<u>C-6 &amp; C-7</u>
	T _____ R _____	_____
	T _____ R _____	_____
	T _____ R _____	_____
2. Property Controlling in Section	S _____ T _____ R _____	_____
	S _____ T _____ R _____	_____
3. Miscellaneous Property in Sec.	S _____ T _____ R _____	_____
	S _____ T _____ R _____	_____

4. Lot No. \_\_\_\_\_, Recorded Plat \_\_\_\_\_

5. Private Claims  
C-6 [W1/4 COR S17] C-7 [NW COR S20]


Recorded 28 June 1996  
9:00 A.M. in Liber 8 Page 146  
*Walter C. Thomas* Reg. of Deeds.  
Delta County, Michigan  
**Register of Deeds Stamp & File Number**

A	B	C	D	E	F	G	H	I	J	K	L	M
2	6	5	4	3	2	1						
3												
4	7	8	9	10	11	12						
5												
6	18	17	16	15	14	13						
7												
8	19	20	21	22	23	24						
9												
10	30	29	28	27	26	25						
11												
12	31	32	33	34	35	36						

I, M.P. DAVIS, in a field survey on MAY, 19 96, do hereby certify that under requirements of P.A. 74, Michigan P.A. of 1970, the corner points mentioned in lines 1 and 2 above were in conformance with regulations and rules therefore as required in the current manual of survey instructions of the United States Department of the Interior, Bureau of Land Management or by a decree of a Court of Law and/or that the corner points mentioned in lines 3, 4 and 5 above were in conformance with the rules of the Michigan Board of Land Surveyors or by a Decree of a Court of Law; established, re-established, monumented, re-monumented, recovered, found as expressed below:

**NOTE: Not more than 4 corners, all in the same town and range, may be recorded on this certificate.**

- A. Description of original monument and accessories and/or subsequent restoration:
- C-6 [W1/4 COR S.17] WOOD POST - A.MERRYWEATHER, D.S. - 1847 (BIRCH 08°-N10°E-20 LINKS) (BIRCH 09°-S10°E-11 LINKS)  
NO RECORD EVIDENCE OF CORNER RECOVERY OR SUBSEQUENT MONUMENTATION
  - C-7 [NW COR S.20] WOOD POST - A.MERRYWEATHER, D.S. - 1847 (CEDAR 10°-N35°W-09 LINKS) (TAMARACK 12°-S55°E-29 LINKS)  
NO RECORD EVIDENCE OF CORNER RECOVERY OR SUBSEQUENT MONUMENTATION
- B. Description of corner evidence found and/or method applied in restoring or reestablishing corner:
- C-6 [W1/4 COR S.17] FOUND IN PLACE A 20" LONG IRON BOLT W/A 1 1/4" SQ. HEAD. BROKEN AND IN POOR CONDITION. THIS MONUMENT PLACED BY PERSON OR PERSONS UNKNOWN BUT IS SIMILAR TO THOSE MONUMENTS SET BY LOCAL LAND SURVEYORS IN THE EARLY & MID 1900'S. EXISTING MONUMENT IS LINE WITH ANCIENT FENCE LINES TO THE NORTH AND SOUTH AND IS IN THE APPROXIMATE CENTER LINE OF THE COUNTY ROAD TO THE EAST. ACCEPTED EXISTING MONUMENT AS BEING THE BEST AVAILABLE EVIDENCE AS TO THE LOCATION OF THE POSITION OF THE ORIGINAL CORNER.
  - C-7 [NW COR S.20] FOUND IN PLACE AND IN POOR CONDITION A 1" IRON PIPE AT THE APPROXIMATE CENTER LINE INTERSECTION OF COUNTY ROADS EAST-WEST AND SOUTH. CORNER MONUMENT PLACED BY PERSON AND/OR PERSONS UNKNOWN. NO OTHER EVIDENCE OR CORNER ACCESSORIES FOUND. ACCEPTED EXISTING MONUMENT AS BEING THE BEST AVAILABLE EVIDENCE AS TO THE LOCATION OF THE POSITION OF THE ORIGINAL CORNER.
- C. Description of monument for corner and accessories established to perpetuate locating the position of the corner:
- C-6 SET OVER EXISTING MONUMENT & 6" BELOW ROAD GRADE A 5/8" X 18" REBAR W/A 3 1/4" ALUMN CAP STAMPED TO ID THE CORNER POSITION.  
MAPLE 8" CEDAR 5" SURVEY MONUMENT SIGN POST NOTE: OPEN FIELD IN THE SW QUADRANT & LARGE SNOPLow TURNAROUND  
N40°W N25°E SOUTH IN THE SE QUADRANT  
35.56' 39.21' 17.26' (TO FACE)
  - C-7 SET OVER EXISTING MONUMENT & 6" BELOW ROAD GRADE A 5/8" X 18" REBAR W/A 3 1/4" ALUMN CAP STAMPED TO ID THE CORNER POSITION.  
CEDAR 13" CUT ON EAST END OF CMP CUT ON WEST END OF CMP SURVEY MONUMENT SIGN POST  
N46°W S08°E S23°W NORTH  
48.02' 59.52' 60.78' 25.11' (TO FACE)

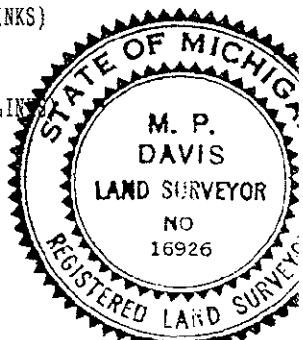

NOTE: BEARINGS TO REFERENCE OBJECTS ARE MAGNETIC - DISTANCES ARE TO A NAIL IN THE CENTER OF THE OBJECT UNLESS NOTED OTHERWISE

Signed by M.P. Davis Date 6/19/96  
Surveyor's Michigan License No. 16926