

# SURVEY & REMONUMENTATION

AUG 20 1996

COMMISSION

Approved By Delta County  
Land Survey Remonumentation  
Peer Group Under Act 345 Of  
P.A. Of 1990 On June 27, 1996

**LAND CORNER RECORDATION CERTIFICATE**  
Filing Requirement of Act 74, Mich. P.A. 1970

*Robert B. ...*  
Acting Chairman

For corners in  
DELTA  
(County)

Located In: Corner Code #

- |                                    |   |      |   |      |             |
|------------------------------------|---|------|---|------|-------------|
| 1. Public Land Survey              | T | 38 N | R | 23 W | <u>C-10</u> |
|                                    | T |      | R |      |             |
|                                    | T |      | R |      |             |
|                                    | T |      | R |      |             |
| 2. Property Controlling in Section | S |      | T | R    |             |
|                                    | S |      | T | R    |             |
| 3. Miscellaneous Property in Sec.  | S |      | T | R    |             |
|                                    | S |      | T | R    |             |

Recorded 28 June 1996  
9:00 A.M. in Liber 8 Page 144  
*William C. ...*  
Delta County, Michigan  
Register of Deeds Stamp & File Number

4. Lot No. \_\_\_\_\_, Recorded Plat \_\_\_\_\_  
5. Private Claims C-10 [W1/4 COR S29] C-11 [NW COR S32]

	A	B	C	D	E	F	G	H	I	J	K	L	M
2	6	5	4	3	2	1							
3													
4	7	8	9	10	11	12							
5													
6	18	17	16	15	14	13							
7													
8	19	20	21	22	23	24							
9													
10	30	29	28	27	26	25							
11													
12	31	32	33	34	35	36							
13													

I, M.P. DAVIS, in a field survey on MAY, 19 96, do hereby certify that under requirements of P.A. 74, Michigan P.A. of 1970, the corner points mentioned in lines 1 and 2 above were in conformance with regulations and rules therefore as required in the current manual of survey instructions of the United States Department of the Interior, Bureau of Land Management or by a decree of a Court of Law and/or that the corner points mentioned in lines 3, 4 and 5 above were in conformance with the rules of the Michigan Board of Land Surveyors or by a Decree of a Court of Law; established, re-established, monumented, re-monumented, recovered, found as expressed below:

**NOTE: Not more than 4 corners, all in the same town and range, may be recorded on this certificate.**

**A. Description of original monument and accessories and/or subsequent restoration:**

**C-10 [W1/4 COR S.29] WOOD POST - A.MERRYWEATHER, D.S. - 1847 (CEDAR 07'-N20°W-10 LINKS) (BIRCH 10'-S37°E-20 LINKS) M.S.McNABB-1926-STAKE IN PLACE SCRIBED '1/4'-NEW B?'S NOTED (CEDAR 9'-S70°E-8') (CEDAR 4'-N70°W-14') M.D.O.T.-R/W PLANS FOR STATE HWY. PROJECT #21-16B SHOW CORNER IN PLACE-NO WIT'S GIVEN**

**C-11 [NW COR S.32] WOOD POST - A.MERRYWEATHER, D.S. - 1847 (TAMARACK 08'-S75°W-13 LINKS) (TAMARACK 07'-N60°E-08 LINKS) M.S.McNABB-1914-STAKE IN PLACE-TAMARACK S35°E 16.5' M.S.McNABB-1920-FROM PREVIOUS SURVEY-NO NEW WIT'S NOTED M.D.O.T.-R/W PLANS FOR STATE HWY. PROJECT #21-16B SHOW CORNER IN PLACE-NO WIT'S GIVEN**

**B. Description of corner evidence found and/or method applied in restoring or reestablishing corner:**

**C-10 [W1/4 COR S.29] FOUND IN PLACE A SQ'D CEDAR POST SCRIBED '1/4' & A 2 1/2" IRON PIPE. ID CORNER MONUMENT AS BEING THAT SAME ONE AS FOUND IN PLACE BY McNABB IN 1926 AS HIS SE CEDAR BT IS STILL GREEN & THE BEARING & DISTANCE TO THE SQ'D POST CHECK. ACCEPTED THE EXISTING MONUMENT AS BEING THE BEST AVAILABLE EVIDENCE AS TO THE LOCATION OF THE POSITION OF THE ORIGINAL CORNER.**

**C-11 [NW COR S.32] FOUND IN PLACE McNABB'S IRON PIPE AND WOOD POST. ID CORNER POSITION FROM RETRACEMENT OF McNABB'S 1927 SURVEY OF SUPERVISOR'S PLAT NO. 1-FORD RIVER TOWNSHIP AS REC'D IN LIBER "B" OF PLATS ON PAGE 50. ACCEPTED EXISTING MONUMENT AS BEING THE BEST AVAILABLE EVIDENCE AS TO THE LOCATION OF THE POSITION OF THE ORIGINAL CORNER.**


**C. Description of monument for corner and accessories established to perpetuate locating the position of the corner:**

**C-10 REPLACED EXISTING POST W/A BERNTSEN ALNB30 ALUMN MONUMENT W/A 3 1/2" CAP STAMPED TO ID THE CORNER POSITION**

CEDAR 4"	CEDAR 10"	CEDAR 7"	CEDAR 9"	SURVEY MONUMENT SIGN POST
N59°W	N75°E	S47°E	S27°W	NORTH
28.48'	10.65'	25.32'	8.47'	2.02' (TO FACE)

**C-11 REPLACED EXISTING MONUMENT W/A 4" X 4" X 36" CONC MONUMENT W/A 3" BRASS CAP STAMPED TO ID THE CORNER POSITION.**

CEDAR 11" OLD BT)	Y.BIRCH 6"	CEDAR 8"	MAPLE 9"	SURVEY MONUMENT SIGN POST
N62°E	S26°E	S99°W	S74°W	N38°W
34.06'	15.84'	44.35'	48.57'	2.15' (TO FACE)

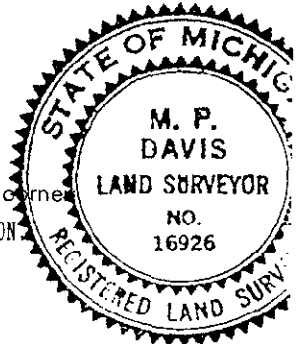

**NOTE: BEARINGS TO REFERENCE OBJECTS ARE MAGNETIC - DISTANCES ARE TO A NAIL IN THE CENTER OF THE OBJECT UNLESS NOTED OTHERWISE**

Signed by M.P. Davis Date 6/19/96

Surveyor's Michigan License No. 16926