

SURVEY & REMONUMENTATION

AUG 20 1996

COMMISSION

Approved By Delta County
Land Survey Remonumentation
Peer Group Under Act 345 Of
P.A. Of 1990 On June 27, 1996

LAND CORNER RECORDATION CERTIFICATE
Filing Requirement of Act 74, Mich. P.A. 1970

Robert Schmalzer
Acting Chairman

For corners in

DELTA
(County)

Located In:

Corner Code ##

- | | | |
|------------------------------------|-----------------------------|------------|
| 1. Public Land Survey | T <u>38</u> N R <u>23</u> W | <u>D-5</u> |
| | T _____ R _____ | |
| | T _____ R _____ | |
| | T _____ R _____ | |
| 2. Property Controlling In Section | S _____ T _____ R _____ | |
| | S _____ T _____ R _____ | |
| 3. Miscellaneous Property in Sec. | S _____ T _____ R _____ | |
| | S _____ T _____ R _____ | |


Recorded 28 June 1996

at 9:00 o'clock A.M. in Liber 8 Page 130

Walter C. Thorne
Reg. of Deeds.
Delta County, Michigan

Register of Deeds Stamp & File Number

4. Lot No. _____, Recorded Plat _____
5. Private Claims D-5 [N1/4 COR 17] D-7 [N1/4 COR S20]

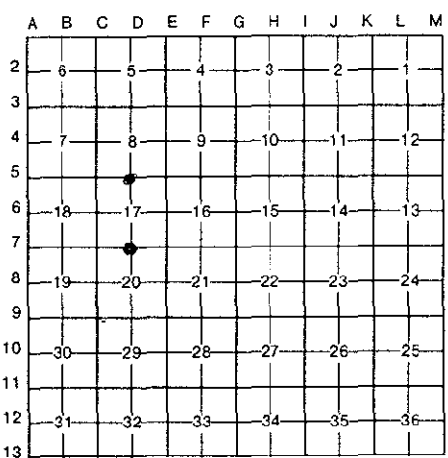

I, M.P. DAVIS, in a field survey on APRIL/MAY, 19 96, do hereby certify that under requirements of P.A. 74, Michigan P.A. of 1970, the corner points mentioned in lines 1 and 2 above were in conformance with regulations and rules therefore as required in the current manual of survey instructions of the United States Department of the Interior, Bureau of Land Management or by a decree of a Court of Law and/or that the corner points mentioned in lines 3, 4 and 5 above were in conformance with the rules of the Michigan Board of Land Surveyors or by a Decree of a Court of Law; established, re-established, monumented, re-monumented, recovered, found as expressed below:


NOTE: Not more than 4 corners, all in the same town and range, may be recorded on this certificate.

A. Description of original monument and accessories and/or subsequent restoration:

- D-5 [N1/4 COR S.17] WOOD POST - A.MERRYWEATHER, D.S. - 1847 (CEDAR 12°-N19°W-13 LINKS) (HEMLOCK 12°-S10°E-08 LINKS)
NO RECORD EVIDENCE OF CORNER RECOVERY OR SUBSEQUENT MONUMENTATION
- D-7 [N1/4 COR S.20] WOOD POST - A.MERRYWEATHER, D.S. - 1847 (TAMARACK 08°-S75°W-13 LINKS) (TAMARACK 07°-N60°E-08 LINKS)
NO RECORD EVIDENCE OF CORNER RECOVERY OR SUBSEQUENT MONUMENTATION

B. Description of corner evidence found and/or method applied in restoring or reestablishing corner:

- D-5 [N1/4 COR S.17] FOUND IN PLACE AT APPROX. C/L PI OF COUNTY ROAD EAST & SOUTH A 1 1/4" IRON PIPE, ORIGIN UNKNOWN. THIS MONUMENT APPEARS TO HAVE BEEN USED IN PREVIOUS SURVEYS IN S.17 AS EXISTING OCCUPATION FITS WELL WITH THIS POSITION. TIMBER OPERATIONS TO THE WEST & NORTH OF THE EXISTING MONUMENT APPARENTLY HAVE HONORED THIS POSITION. THE EXISTING MONUMENT IS 0.03' SOUTH & 22.02' WEST OF A MIDPOINT POSITION BETWEEN SEC COR'S E & W. NO OTHER EVIDENCE OR ACCESSORIES TO THIS CORNER WERE FOUND. ACCEPTED EXISTING MONUMENT AS BEING THE BEST AVAILABLE EVIDENCE AS TO THE LOCATION OF THE POSITION OF THE ORIGINAL CORNER.
- D-7 [N1/4 COR S.20] FOUND IN PLACE A 3/4" SOLID IRON PIN AT THE APPROX. C/L PI OF COUNTY ROADS E-W & N. ORIGIN UNKNOWN. THIS MONUMENT FITS WELL WITH EXISTING OCCUPATION AND ROAD IMPROVEMENTS. THE EXISTING MONUMENT IS APPROX. 7' NORTH & 0.57' WEST OF THE MIDPOINT POSITION BETWEEN SEC CORNERS E & W. NO OTHER EVIDENCE OR ACCESSORIES TO THIS CORNER WERE FOUND. ACCEPTED THE EXISTING MONUMENT AS BEING THE BEST AVAILABLE EVIDENCE AS TO THE LOCATION OF THE POSITION OF THE ORIGINAL CORNER.

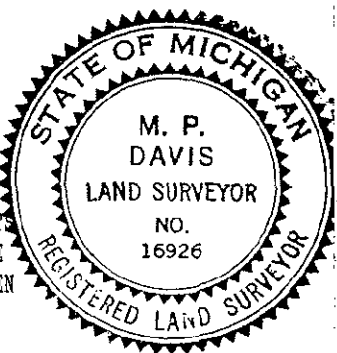

C. Description of monument for corner and accessories established to perpetuate locating the position of the corner:

- D-5 SET OVER EXISTING MONUMENT & 6" BELOW ROAD GRADE A 5/8" X 18" REBAR W/A 3 1/4" ALUMN CAP STAMPED TO ID THE CORNER POSITION.
- | | | | | |
|----------|----------|----------|------------------|---------------------------|
| CEDAR 5" | CEDAR 7" | CEDAR 5" | POWER POLE | SURVEY MONUMENT SIGN POST |
| N75°W | N25°E | S60°E | S57°W | N57°E |
| 32.27' | 47.20' | 66.88' | 43.07' (TO FACE) | 30.03' (TO FACE) |
- D-7 SET OVER EXISTING MON A 5/8" X 18" REBAR W/A 3 1/4" ALUMN CAP STAMPED TO ID THE COR POSITION & RAISED TO RD SURFACE W/A MON BOX CUT ON NORTH END "CMP" CUT ON SOUTH END "CMP" 2 1/2" GALV RD SIGN POST CUT ON EAST END OF "CMP"
- | | | | |
|--------|--------|------------------|--------|
| N40°W | S35°W | N50°E | S25°E |
| 36.75' | 27.11' | 55.80' (TO FACE) | 31.21' |

NOTE: BEARINGS TO REFERENCE OBJECTS ARE MAGNETIC - DISTANCES ARE TO A NAIL IN THE CENTER OF THE OBJECT UNLESS NOTED OTHERWISE

Signed by M.P. Davis Date 6/19/96
Surveyor's Michigan License No. 16926