

SURVEY & REMONUMENTATION COMMISSION

AUG 20 1996

COMMISSION

Approved By Delta County
Land Survey Remonumentation
Peer Group Under Act 345 Of
P.A. Of 1990 On June 27, 1996

LAND CORNER RECORDATION CERTIFICATE
Filing Requirement of Act 74, Mich. P.A. 1970

Robert A. Schmalzer
Acting Chairman

For corners in
DELTA
(County)

Located In: Corner Code ##

- | | | |
|---------------------------------------|-----------------------------|------------------|
| 1. Public Land Survey | T <u>38</u> N R <u>23</u> W | <u>E-2</u> & E-5 |
| | T _____ R _____ | _____ |
| | T _____ R _____ | _____ |
| | T _____ R _____ | _____ |
| 2. Property Controlling
in Section | S _____ T _____ R _____ | _____ |
| | S _____ T _____ R _____ | _____ |
| 3. Miscellaneous
Property in Sec. | S _____ T _____ R _____ | _____ |
| | S _____ T _____ R _____ | _____ |

Recorded 28 June 1996
9:00 A.M. in Liber 8 Page 142
William C. Thomas Reg. of Deeds.
Delta County, Michigan
Register of Deeds Stamp & File Number

4. Lot No. _____, Recorded Plat _____
5. Private Claims E-2 [W1/4 COR S.4] E-5 [NW COR S.16]

A	B	C	D	E	F	G	H	I	J	K	L	M
2	6	5	4	3	2	1						
3												
4	7	8	9	10	11	12						
5												
6	18	17	16	15	14	13						
7												
8	19	20	21	22	23	24						
9												
10	30	29	28	27	26	25						
11												
12	31	32	33	34	35	36						


I, K.P. DAVIS, in a field survey on MAY, 19 96, do hereby certify that under requirements of P.A. 74, Michigan P.A. of 1970, the corner points mentioned in lines 1 and 2 above were in conformance with regulations and rules therefore as required in the current manual of survey instructions of the United States Department of the Interior, Bureau of Land Management or by a decree of a Court of Law and/or that the corner points mentioned in lines 3, 4 and 5 above were in conformance with the rules of the Michigan Board of Land Surveyors or by a Decree of a Court of Law; established, re-established, monumented, re-monumented, recovered, found as expressed below:

NOTE: Not more than 4 corners, all in the same town and range, may be recorded on this certificate.

- A. Description of original monument and accessories and/or subsequent restoration:
E-2 [W1/4 COR S.4] WOOD POST - A.MERRYWEATHER, D.S. - 1847 (BIRCH 07"-N20°W-06 LINKS) (TAMARACK 07"-S21°E-13 LINKS)
M.S.McNABB-1946-ESTABLISHED CORNER "1/2 DIST & DIRECT LINE BETWEEN CORNERS (NORWAY 9" N41°W 12.5')(NORWAY 8" S5°E 13.7')
E-5 [NW COR S.16] WOOD POST - A.MERRYWEATHER, D.S. - 1847 (BIRCH 06"-N32°W-25 LINKS) (BIRCH 06"-S40°E-07 LINKS)
D.A.BROTHERTON-1910-FROM ORIGINALS RESET STEEL BLADE-BT STAKES NW & SE 20'
M.S.McNABB-1917-ID CORNER BY BT STAKES IN PREVIOUS SURVEYS
M.DAVIS-1973-FOUND I.P. IN STONE MOUND & NOTED FOLLOWING NEW BT'S (MAPLE 12" N27°W 58.5')(TWIN MAPLE 20" S2°E 45.9')(PP N76°E 116.4') REC'D LIBER 1 OF LCR'S PG. 294

- B. Description of corner evidence found and/or method applied in restoring or reestablishing corner:
E-2 [W1/4 COR S.4] FOUND IN PLACE McNABB'S 1946 WOOD POST SCRIBED "1/4", ID CORNER MONUMENT FROM McNABB'S SE BT WHICH IS STILL GREEN. ACCEPTED THE EXISTING MONUMENT AS BEING A CAREFUL AND FAITHFUL PERPETUATION OF THE POSITION OF THE ORIGINAL CORNER.

- E-5 [NW COR S.16] FOUND IN PLACE AS FOUND BY MYSELF IN 1973 AND RECORDED IN LIBER 1 OF LCR'S ON PAGE 294. SE MAPLE BT AS NOTED IN 1973 STILL GREEN. ACCEPTED EXISTING MONUMENT AS BEING A CAREFUL AND FAITHFUL PERPETUATION OF THE POSITION OF THE ORIGINAL CORNER.

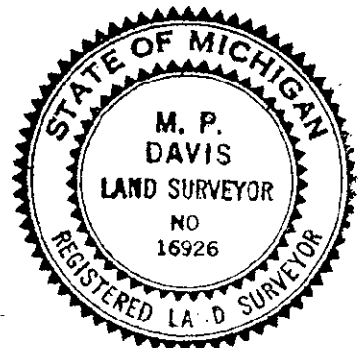

- C. Description of monument for corner and accessories established to perpetuate locating the position of the corner:

E-2 REPLACED EXISTING MONUMENT W/A 4" X 4" X 36" CONC. MONUMENT W/A 3" BRASS CAP STAMPED TO ID THE CORNER POSITION.
RED PINE 7" SPRUCE 5" RED PINE 6" SURVEY MONUMENT SIGN POST
N43°W N67°E S57°E WEST
8.21' 14.54' 22.05' 1.65' (TO FACE)

E-5 SET OVER EXISTING MON & RAISED TO ROAD SURFACE W/A MON BOX A 5/8" X 18" REBAR W/A 3 1/4" ALUMN CAP STAMPED TO ID THE COR POSITION.
DRILL HOLE IN FIELD STONE DRILL HOLE IN FIELD STONE DRILL HOLE IN FIELD STONE SURVEY MONUMENT SIGN POST
N51°W S02°W S58°W S45°E
49.98' 32.32' 45.11' 27.10' (TO FACE)

NOTE: BEARINGS TO REFERENCE OBJECTS ARE MAGNETIC - DISTANCES ARE TO A NAIL IN THE CENTER OF THE OBJECT UNLESS NOTED OTHERWISE

Signed by M.P. Davis Date 6/19/96
Surveyor's Michigan License No. 16926