

SURVEY & REMONUMENTATION

AUG 20 1996

COMMISSION

LAND CORNER RECORDATION CERTIFICATE
Filing Requirement of Act 74, Mich. P.A. 1970

Approved By Delta County
Land Survey Remonumentation
Peer Group Under Act 345 Of
P.A. Of 1990 On June 27, 1996

Robert B. Threlking
acting Chairman

For corners in
DELTA
(County)

Located In: Corner Code #/

1. Public Land Survey	T	38 NR	23 W	I-5
	T	_____ R	_____	_____
	T	_____ R	_____	_____
	T	_____ R	_____	_____
2. Property Controlling in Section	S	_____ T	_____ R	_____
	S	_____ T	_____ R	_____
3. Miscellaneous Property in Sec.	S	_____ T	_____ R	_____
	S	_____ T	_____ R	_____

Recorded 28 June 1996
at 9:00 clock A.M. in Liber 8 Page 134
Walter C. Thum Reg. of Deeds.
Delta County, Michigan
Register of Deeds Stamp & File Number

4. Lot No. _____, Recorded Plat _____
5. Private Claims
I-4 [W1/4 COR S.11] I-5 [NW COR S.14]

	A	B	C	D	E	F	G	H	I	J	K	L	M
2	6	5	4	3	2	1							
3													
4	7	8	9	10	11	12							
5													
6	18	17	16	15	14	13							
7													
8	19	20	21	22	23	24							
9													
10	30	29	28	27	26	25							
11													
12	31	32	33	34	35	36							
13													


I, M.P. DAVIS, in a field survey on MAY, 19 96, do hereby certify that under requirements of P.A. 74, Michigan P.A. of 1970, the corner points mentioned in lines 1 and 2 above were in conformance with regulations and rules therefore as required in the current manual of survey instructions of the United States Department of the Interior, Bureau of Land Management or by a decree of a Court of Law and/or that the corner points mentioned in lines 3, 4 and 5 above were in conformance with the rules of the Michigan Board of Land Surveyors or by a Decree of a Court of Law; established, re-established, monumented, re-monumented, recovered, found as expressed below:

NOTE: Not more than 4 corners, all in the same town and range, may be recorded on this certificate.

A. Description of original monument and accessories and/or subsequent restoration:
I-4 [W1/4 COR S11] WOOD POST - A.MERRYWEATHER, D.S. - 1847 - (HEMLOCK 16'-N10°E-23 LINKS)(CEDAR 04°-S37°W-14 LINKS)
M.DAVIS-1975-NO CORNER MONUMENTATION OR ACCESSORIES FOUND-RESTORED CORNER FROM EXISTING LINES OF OCCUPATION & EXISTING SURVEY MONUMENTS FOUND IN PLACE BY PERSONS UNKNOWN, SET 1' X 36" I.P. FROM WHICH (PP-N45°E.-30.2')(PP-N41°W-30.6')(CONC. SURVEY MONUMENTS EAST 33.0' & 208.0') RECORDED SAME IN LIBER 2 OF LCR'S PAGE 104.

I-5 [NW COR S14] WOOD POST - A.MERRYWEATHER, D.S.-1847-(CEDAR 12°-N09°E-36 LINKS)(CEDAR 10°-S32°W-22 LINKS)
M.S.McNABB-1931-I.P. IN PLACE - CORNER FENCE POST WEST 19.5'
M.DAVIS-1975-FOUND 1 1/2" X 26" I.P. IN PLACE FROM WHICH (PP-S51°W-37.9')(SPRUCE 24°-N51°E-122.8') & REC'D IN LIBER 2 LCR'S PG 104

B. Description of corner evidence found and/or method applied in restoring or reestablishing corner:
I-4 [W1/4 COR S11] FOUND IN PLACE, 1" X 36" IRON PIPE AS SET BY MYSELF IN 1975 & REC'D IN LIBER 2 OF LCR'S PG.104. ID COR. MONUMENT BY CONCRETE MON'S TO THE EAST AS FOUND IN 1979. ACCEPTED EXISTING MONUMENT AS BEING THE BEST AVAILABLE EVIDENCE AS TO THE LOCATION OF THE POSITION OF THE ORIGINAL CORNER.
I-5 [NW COR S.14] FOUND IN PLACE 1 1/2" IRON PIPE AS FOUND BY MYSELF IN 1975 & REC'D IN LIBER 2 OF LCR'S ON PAGE 104. ID COR MONUMENT BY 1975 SPRUCE BT TO THE NE (STILL GREEN). ACCEPTED EXISTING MONUMENT AS BEING THE BEST AVAILABLE EVIDENCE AS TO THE LOCATION OF THE POSITION OF THE ORIGINAL CORNER.

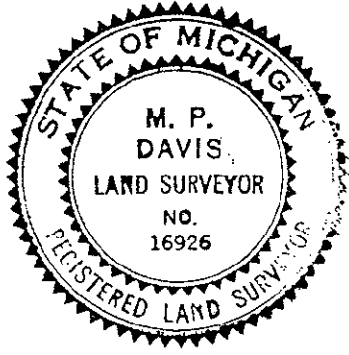

C. Description of monument for corner and accessories established to perpetuate locating the position of the corner:
I-4 SET, INSIDE EXISTING MON, A 5/8" X 18" REBAR W/A 3 1/4" ALUM CAP STAMPED TO ID THE COR POSITION & RAISED TO RD GRADE W/A MON BOX
TELE POLE POWER POLE NE COR HOUSE FOUNDATION
N38°W N58°E S64°W
30.20' (TO FACE) 36.92' (TO FACE) 85.01'
I-5 SET, INSIDE EXISTING MON, A 5/8" X 18" REBAR W/A 3 1/4" ALUM CAP STAMPED TO ID THE COR POSITION & RAISED TO RD GRADE W/A MON BOX
DRILL HOLE IN FIELD STONE CUT ON SOUTH END OF "CMP" SURVEY MONUMENT SIGN POST NOTE: NO OTHER WIT'S AVAILABLE,
N53°E S44°W SOUTH COR POSITION IS APPROX C/L
96.46' 26.26' 15.46' (TO FACE) PI OF C.R. N & E

NOTE: BEARINGS TO REFERENCE OBJECTS ARE MAGNETIC - DISTANCES ARE TO A NAIL IN THE CENTER OF THE OBJECT UNLESS NOTED OTHERWISE
Signed by M.P. Davis Date 6/19/96

Surveyor's Michigan License No. 16926