

SURVEY & REMONUMENTATION

AUG 20 1996

LAND CORNER RECORDATION CERTIFICATE
Filing Requirement of Act 74, Mich. P.A. 1970

Approved By Delta County
Land Survey Remonumentation
Peer Group Under Act 345 of
P.A. Of 1990 On June 27, 1996

Phillip Schmeling
acting Chairman


For corners in **COMMISSION**
DELTA
(County)

Located In: Corner Code #

- | | | | | | |
|------------------------------------|---|-------------|---|-------------|------------|
| 1. Public Land Survey | T | <u>38 N</u> | R | <u>23 W</u> | <u>K-2</u> |
| | T | _____ | R | _____ | _____ |
| | T | _____ | R | _____ | _____ |
| | T | _____ | R | _____ | _____ |
| 2. Property Controlling in Section | S | _____ | T | _____ | _____ |
| | S | _____ | T | _____ | _____ |
| 3. Miscellaneous Property in Sec. | S | _____ | T | _____ | _____ |
| | S | _____ | T | _____ | _____ |

Recorded 28 June 1996
at 9:00 o'clock A.M. in Liber 8 Page 133
Walter C. Thum Reg. of Deeds.
Delta County, Michigan
Register of Deeds Stamp & File Number

4. Lot No. _____, Recorded Plat _____
5. Private Claims J-3 [N1/4 COR S.11] K-2 [W1/4 COR S.1]

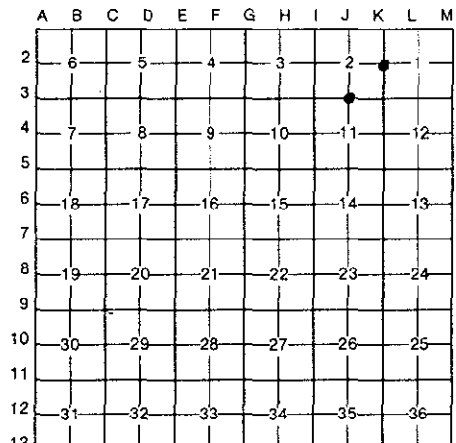

I, M.P. DAVIS, in a field survey on MAY, 19 96, do hereby certify that under requirements of P.A. 74, Michigan P.A. of 1970, the corner points mentioned in lines 1 and 2 above were in conformance with regulations and rules therefore as required in the current manual of survey instructions of the United States Department of the Interior, Bureau of Land Management or by a decree of a Court of Law and/or that the corner points mentioned in lines 3, 4 and 5 above were in conformance with the rules of the Michigan Board of Land Surveyors or by a Decree of a Court of Law; established, re-established, monumented, re-monumented, recovered, found as expressed below:


NOTE: Not more than 4 corners, all in the same town and range, may be recorded on this certificate.

A. Description of original monument and accessories and/or subsequent restoration:

- J-3 [N1/4 COR S.11] WOOD POST - A.MERRYWEATHER, D.S. - 1847 - (CEDAR 10'-N44°W-10 LINKS)(TAMARACK 06'-S68°E-05 LINKS) D.A.BROTHERTON-1912-STAKE IN PLACE-NO WIT'S NOTED
- K-2 [W1/4 COR S1] WOOD POST - A.MERRYWEATHER, D.S. - 1847 - (BIRCH 10'-N80°E-07 LINKS)(BIRCH 06'-N65°W-06 LINKS) M.S.McNABB-1919-ID BY STAKE AND WIT'S IN PLACE (POPLAR 9' N70°E 11.4')(TAM 10' S25°W 12.5') ESCANABA CITY ENGINEERS RECORDS SHOW CONC. MONUMENT IN PLACE - NO DATE GIVEN OR WIT'S SHOWN

B. Description of corner evidence found and/or method applied in restoring or reestablishing corner:

- J-3 [N1/4 COR S.11] NO CORNER EVIDENCE OR ACCESSORIES FOUND. ESTABLISHED CORNER POSITION AT MIDPOINT BETWEEN SECTION CORNERS 1/2 MILE EAST & WEST.
- K-2 [W1/4 COR S.1] FOUND IN PLACE 6" CONC MONUMENT W/A 3/4" BRASS ROD CENTER STAMPED "1/4". NO EVIDENCE OF McNABB'S 1919 WIT'S FOUND. ACCEPTED EXISTING MONUMENT AS BEING THE BEST AVAILABLE EVIDENCE AS TO THE LOCATION OF THE POSITION OF THE ORIGINAL CORNER.

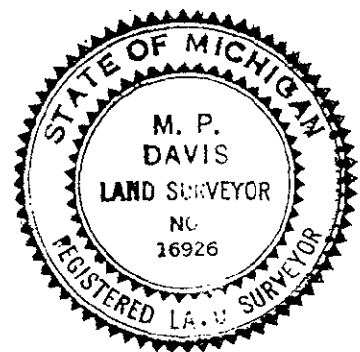

C. Description of monument for corner and accessories established to perpetuate locating the position of the corner:

- J-3 SET, INSIDE A MON BOX, A 5/8" X 18" REBAR W/A 3/4" ALUMN CPA STAMPED TO ID THE CORNER POSITION.
- | | | | |
|----------|-----------|------------|---------------------------|
| CEDAR 9" | CEDAR 10" | W.BIRCH 4" | SURVEY MONUMENT SIGN POST |
| N62°E | S28°E | S46°W | N30°W |
| 55.25' | 71.14' | 60.56' | 40.40' (TO FACE) |
- K-2 DID NOT DISTURB EXISTING MONUMENT
- | | | | | | |
|--------|----------|----------|----------|---------------------------|------------------------|
| ASH 6" | MAPLE 6" | MAPLE 7" | MAPLE 6" | SURVEY MONUMENT SIGN POST | AIRPORT SECURITY FENCE |
| N50°W | S43°E | S25°W | S73°W | EAST | NORTH |
| 2.86' | 10.47' | 19.53' | 14.32' | 2.82' (TO FACE) | 9.95' |

NOTE: BEARINGS TO REFERENCE OBJECTS ARE MAGNETIC - DISTANCES ARE TO A NAIL IN THE CENTER OF THE OBJECT UNLESS NOTED OTHERWISE

Signed by M.P. Davis Date 6/19/96
Surveyor's Michigan License No. 16926