

SURVEY & REMONUMENTATION

SEP 13 1994

COMMISSION

Approved By Delta County
Land Survey Remonumentation
Peer Group Under Act 345 Of
P.A. Of 1990 On July 13, 1994
Walter E. Thoren
Chairman

LAND CORNER RECORDATION CERTIFICATE
Filing Requirement of Act 74, Mich. P.A. 1970

For corners in
DELTA
(County)

Located In: Corner Code #

- | | | | | | |
|------------------------------------|---|------|---|------|-------------|
| 1. Public Land Survey | T | 38 N | R | 24 W | A-11 & A-12 |
| | T | | R | | |
| | T | | R | | |
| | T | | R | | |
| 2. Property Controlling in Section | S | | T | R | |
| | S | | T | R | |
| 3. Miscellaneous Property in Sec. | S | | T | R | |
| | S | | T | R | |

Recorded Aug 12 1994
at 9:00 o'clock AM in Liber 8 Page 32
Walter E. Thoren
Reg. of Deeds.
Delta County, Michigan

Register of Deeds Stamp & File Number

4. Lot No. _____, Recorded Plat _____
5. Private Claims A-11 [NW COR S.33] A-12 [W1/4 COR S.31]

A	B	C	D	E	F	G	H	I	J	K	L	N
2	6	5	4	3	2	1						
3												
4	7	8	9	10	11	12						
5												
6	13	17	16	15	14	13						
7												
8	19	20	21	22	23	24						
9												
10	30	29	28	27	26	25						
11												
12	31	32	33	34	35	36						
13												

I, M.P. DAVIS, in a field survey on JULY, 19 94, do hereby certify that under requirements of P.A. 74, Michigan P.A. of 1970, the corner points mentioned in lines 1 and 2 above were in conformance with regulations and rules therefore as required in the current manual of survey instructions of the United States Department of the Interior, Bureau of Land Management or by a decree of a Court of Law and/or that the corner points mentioned in lines 3, 4 and 5 above were in conformance with the rules of the Michigan Board of Land Surveyors or by a Decree of a Court of Law; established, re-established, monumented, re-monumented, recovered, found as expressed below:


NOTE: Not more than 4 corners, all in the same town and range, may be recorded on this certificate.

A. Description of original monument and accessories and/or subsequent restoration:
A-11 [NW COR S.31] WOOD POST - JAMES H. MULLETTE, D.S. - 1848 (SUGAR 12"-S30°W-28 LINKS) (HEMLOCK 10"-N85°W-27 LINKS)
GEORGE ADAIR, D.S. - WOOD POST - 1852 (SUGAR 12"-N112°E-15 LINKS) (BEECH 6"-S54°E-48 LINKS)
M.S. McNABB-1915-FOUND STAKE IN PLACE & REMAINS OF ORIGINAL BT, WHICH ONE NOT IDENTIFIED IN HIS RECORDS-SET BY STAKES NW & SE 33'

A-12 [W1/4 COR S.31] WOOD POST - JAMES H. MULLETTE, D.S. - 1848 (BEECH 8"-N49°W-12 LINKS) (LYNN 6"-S23°W-20 LINKS)
NO RECORD EVIDENCE OF SUBSEQUENT CORNER RECOVERY OR MONUMENTATION

B. Description of corner evidence found and/or method applied in restoring or reestablishing corner:
A-11 [NW COR S.31] FOUND IN PLACE McNABB'S 1915 IRON BOLT "FROM ORIGINAL BT". NO EVIDENCE OF HIS BT STAKES FOUND. MEASUREMENTS TO CORNER MONUMENTS FOUND TO THE NORTH CHECK WELL WITH McNABB'S RECORDS. ACCEPTED EXISTING MONUMENT AS BEING A CAREFUL & FAITHFUL PERPETUATION OF THE POSITION OF THE ORIGINAL CORNER POSITION.

A-12 [W1/4 COR S.31] NO CORNER EVIDENCE FOUND, REESTABLISHED CORNER POSITION AT THE MIDPOINT BETWEEN SEC CORNERS N & S. CORNER MONUMENT IS IN THE EAST WHEEL PATH OF A N-S WOODS ROAD

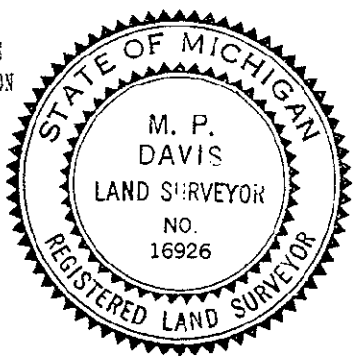

C. Description of monument for corner and accessories established to perpetuate locating the position of the corner:

A-11 SET, OVER EXISTING MONUMENT, A 5/8" X 18" REBAR W/A 3-1/4" ALUMN CAP STAMPED TO ID THE CORNER POSITION.
CEDAR 7" MAPLE 4" MAPLE 9" MAPLE 10" SURVEY MONUMENT SIGN POST
N43°W N57°E S46°E S74°W EAST
42.87' 48.44' 29.83' 43.58' 15.91' (TO FACE)

A-12 SET A 5/8" X 18" REBAR W/A 3-1/4" ALUMN CAP STAMPED TO ID THE CORNER POSITION.
BASSWOOD 8" RED PINE 10" RED PINE 6" BASSWOOD 8" SURVEY MONUMENT SIGN POST
N44°W N45°E S45°E S71°W WEST
42.63' 22.80' 19.66' 43.52' 12.68' (TO FACE)

NOTE: BEARINGS TO REFERENCE OBJECTS ARE MAGNETIC - DISTANCES ARE TO A NAIL IN THE CENTER OF THE OBJECT UNLESS NOTED OTHERWISE

Signed by M.P. Davis Date 7/11/94

Surveyor's Michigan License No. 16726