

SURVEY & REMONUMENTATION

SEP 13 1994

COMMISSION

LAND CORNER RECORDATION CERTIFICATE
Filing Requirement of Act 74, Mich. P.A. 1970

Approved By Delta County
Land Survey Remonumentation
Peer Group Under Act 345 Of
P.A. Of 1990 On July 13, 1994

M. P. Davis
Acting Chairman

For corners in
DELTA
(County)

Located In: Corner Code ##

- | | | |
|------------------------------------|-----------------------------|-----------------------|
| 1. Public Land Survey | T <u>38 N</u> R <u>24 W</u> | <u>B-9 & B-11</u> |
| | T _____ R _____ | _____ |
| | T _____ R _____ | _____ |
| | T _____ R _____ | _____ |
| 2. Property Controlling in Section | S _____ T _____ R _____ | _____ |
| | S _____ T _____ R _____ | _____ |
| 3. Miscellaneous Property in Sec. | S _____ T _____ R _____ | _____ |
| | S _____ T _____ R _____ | _____ |

Recorded Aug 12 1994
at 9:00 o'clock AM in Liber 8 Page 36

M. P. Davis Reg. of Deeds.
Delta County, Michigan

Register of Deeds Stamp & File Number

4. Lot No. _____, Recorded Plat _____
5. Private Claims B-9 [N1/4 COR S.30] B-11 [N1/4 COR S.31]

	A	B	C	D	E	F	G	H	I	J	K	L	I
2	6	5	4	3	2	1							
3													
4	7	8	9	10	11	12							
5													
6	18	17	16	15	14	13							
7													
8	19	20	21	22	23	24							
9													
10	30	29	28	27	26	25							
11													
12	31	32	33	34	35	36							
13													

I, M.P. DAVIS, in a field survey on JULY, 19 94, do hereby certify that under requirements of P.A. 74, Michigan P.A. of 1970, the corner points mentioned in lines 1 and 2 above were in conformance with regulations and rules therefore as required in the current manual of survey instructions of the United States Department of the Interior, Bureau of Land Management or by a decree of a Court of Law and/or that the corner points mentioned in lines 3, 4 and 5 above were in conformance with the rules of the Michigan Board of Land Surveyors or by a Decree of a Court of Law; established, re-established, monumented, re-monumented, recovered, found as expressed below:

NOTE: Not more than 4 corners, all in the same town and range, may be recorded on this certificate.

A. Description of original monument and accessories and/or subsequent restoration:


B-9 [N1/4 COR S.30] GEORGE ADAIR, D.S. - WOOD POST - 1852 (HEMLOCK 8°-N52°W-36 LINKS) (Y. BIRCH 10°-S15°E-26 LINKS)
NO RECORD EVIDENCE OF SUBSEQUENT CORNER RECOVERY OR MONUMENTATION

B-11 [N1/4 COR S.31] WOOD POST - GEORGE ADAIR, D.S. - 1852 - (TAMARACK 8°-N75°E-09 LINKS) (TAMARACK 12°-S57°W-28 LINKS)
NO RECORD EVIDENCE OF SUBSEQUENT CORNER RECOVERY OR MONUMENTATION

B. Description of corner evidence found and/or method applied in restoring or reestablishing corner:

B-9 [N1/4 COR S.30] NO EVIDENCE OF CORNER MONUMENTATION FOUND. REESTABLISHED CORNER POSITION ON LINE WITH & SINGLE PROPORTIONATE DISTANCE BETWEEN SEC CORNERS EAST & WEST. CORNER POSITION FALLS IN LINE WITH FARM FENCE NORTH & 15' EAST OF FARM FENCE SOUTH.

B-11 [N1/4 COR S.31] NO EVIDENCE OF CORNER MONUMENTATION FOUND. REESTABLISHED CORNER POSITION ON LINE WITH & SINGLE PROPORTIONATE DISTANCE BETWEEN CORNERS EAST & WEST. CORNER IS LOCATED IN A DENSE CEDAR SWAMP, NO OCCUPATION INDICATED.

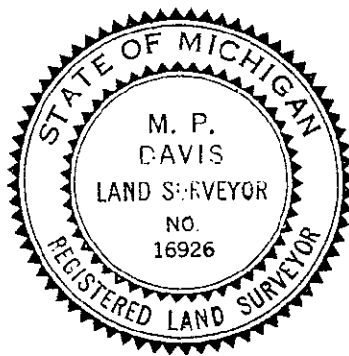

C. Description of monument for corner and accessories established to perpetuate locating the position of the corner:

B-9 SET, 6" BELOW RD SURFACE, A 5/8" X 18" REBAR W/A 3-1/4" ALUMN CAP STAMPED TO ID THE CORNER POSITION.
CEDAR 5" SURVEY MONUMENT SIGN POST NORTH NOTE: CORNER POSITION IS SURROUNDED BY CULTIVATED FARM FIELDS, NO OTHER WIT'S ARE AVAILABLE.
S55°W 62.08' 14.09' (TO FACE)

B-11 SET BERNTSEN A1NB30 ALUMN MONUMENT WITH THE CAP STAMPED TO ID THE CORNER POSITION.
CEDAR 8" CEDAR 9" TAMARACK 9" CEDAR 6" SURVEY MONUMENT SIGN POST NORTH
S73°W N65°E S81°E S3°W 9.10' 17.93' 53.31' 24.22' 2.31' (TO FACE)

NOTE: BEARINGS TO REFERENCE OBJECTS ARE MAGNETIC - DISTANCES ARE TO A NAIL IN THE CENTER OF THE OBJECT UNLESS NOTED OTHERWISE

Signed by M. P. Davis Date 7/11/94
Surveyor's Michigan License No. 16926