

SURVEY & REMONUMENTATION

APR 07 1995

COMMISSION

For corners in:

DELTA
(County)

Located In:

Corner Code ##

- | | | |
|------------------------------------|-------------------------|-----|
| 1. Public Land Survey | T 38 N R 24 W | C-7 |
| | T _____ R _____ | |
| | T _____ R _____ | |
| | T _____ R _____ | |
| 2. Property Controlling in Section | S _____ T _____ R _____ | |
| | S _____ T _____ R _____ | |
| 3. Miscellaneous Property in Sec. | S _____ T _____ R _____ | |
| | S _____ T _____ R _____ | |

Approved By Delta County
Land Survey Remonumentation
Peer Group Under Act 345 Of
P.A. Of 1990 On 10/29, 1994
Robert Schmelting
Acting Chairman

Recorded OCT - 4 1994
at 9:00 o'clock AM in Liber 8 Page 49
William C. Thomas Reg. of Deeds.
Delta County, Michigan
Register of Deeds Stamp & File Number

4. Lot No. _____, Recorded Plat _____
5. Private Claims _____
C-7 [NW COR S.20] C-8 [W1/4 COR S.20]

I, M.P. DAVIS, in a field survey on _____, 19 94, do hereby certify that under requirements of P.A. 74, Michigan P.A. of 1970, the corner points mentioned in lines 1 and 2 above were in conformance with regulations and rules therefore as required in the current manual of survey instructions of the United States Department of the Interior, Bureau of Land Management or by a decree of a Court of Law and/or that the corner points mentioned in lines 3, 4 and 5 above were in conformance with the rules of the Michigan Board of Land Surveyors or by a Decree of a Court of Law; established, re-established, monumented, re-monumented, recovered, found as expressed below:

A	B	C	D	E	F	G	H	I	J	K	L	M
2	6	5	4	3	2	1						
3												
4	7	8	9	10	11	12						
5												
6	18	17	16	15	14	13						
7												
8	19	20	21	22	23	24						
9												
10	30	29	28	27	26	25						
11												
12	31	32	33	34	35	36						
13												


NOTE: Not more than 4 corners, all in the same town and range, may be recorded on this certificate.

A. Description of original monument and accessories and/or subsequent restoration:
C-7 [NW COR S.20] WOOD POST - GEORGE ADAIR, D.S. - 1852 - (BEECH 13°-N76°W-34 LINKS) (BEECH 13°-S42°E-44 LINKS) 1884 RECORDS OF C.E. BROTHERTON SHOW CORNER IN PLACE-NO WIT'S NOTED OR DESCRIPTION OF EXISTING MONUMENT GIVEN
M.S. McNABB-1940-ESTABLISHED FROM IMPROVEMENTS-NO WIT'S OR DESCRIPTION OF MONUMENT NOTED
M. DAVIS-1974-SET TRACK SPIKE-ESTABLISHED CORNER POSITION FROM EXISTING OCCUPATION & IMPROVEMENTS (MAPLE 20°-S20°E-92.6') (POWER POLE-S42°W-39.25')

C-8 [W1/4 COR S.20] WOOD POST - GEORGE ADAIR, D.S. - 1852 (SUGAR 6°-N56°W-14 LINKS)(BEECH 7°-S62°W-12 LINKS)
NO RECORD EVIDENCE OF SUBSEQUENT CORNER RECOVERY OR MONUMENTATION

B. Description of corner evidence found and/or method applied in restoring or reestablishing corner:
C-7 [NW COR S.20] FOUND IN PLACE TRACK SPIKE AS SET BY MYSELF IN 1974. ID CORNER MONUMENT FROM EXISTING WIT'S (MAPLE SE & PP SW) AS NOTED IN LIBER 1 OF LCR'S ON PAGE 463

C-8 [W1/4 COR S.20] ESTABLISHED CORNER POSITION AT MIDPOINT BETWEEN SECTION CORNERS NORTH & SOUTH. THIS POSITION FALLS IN LINE WITH ANCIENT FARM FENCE TO THE WEST & OCCUPATION TO THE EAST.

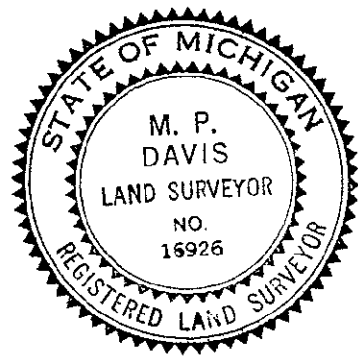

C. Description of monument for corner and accessories established to perpetuate locating the position of the corner:

C-7 SET IN SIDE A MON BOX A 5/8" X 18" REBAR W/A 3-1/4" ALUMN CAP STAMPED TO ID THE CORNER POSITION.
MAPLE 13" SURVEY MONUMENT SIGN POST MAPLE 28" POWER POLE
N64°W N70°E S18°E S43°W
56.28' 32.39' (TO FACE) 92.05' 38.70' (TO FACE)

C-8 SET INSIDE A MON BOX A 5/8" X 18" REBAR W/A 3-1/4" ALUMN CAP STAMPED TO ID THE CORNER POSITION.
POWER POLE W.BIRCH 5" W.BIRCH 5" SURVEY MONUMENT SIGN PGST
N14°W N74°E S28°E WEST
85.66' (TO FACE) 79.82' 105.40' 16.92' (TO FACE)

NOTE: BEARINGS TO REFERENCE OBJECTS ARE MAGNETIC - DISTANCES ARE TO A NAIL IN THE CENTER OF THE OBJECT UNLESS NOTED OTHERWISE

Signed by M.P. Davis Date 9/28/94
Surveyor's Michigan License No. 16926