

SURVEY & REMONUMENTATION

OCT 26 1995

COMMISSION

Approved by Lena County
Land Survey Remonumentation
Peer Group Under Act 345 Of
P.A. Of 1990 On June 6, 1995

[Signature]
Acting Chairman

LAND CORNER RECORDATION CERTIFICATE
Filing Requirement of Act 74, Mich. P.A. 1970

For corners in
DELTA
(County)

Located In: Corner Code #

- | | | |
|------------------------------------|-----------------------------|-----------------------|
| 1. Public Land Survey | T <u>38</u> N R <u>24</u> W | <u>D-9 & D-11</u> |
| | T _____ R _____ | _____ |
| | T _____ R _____ | _____ |
| | T _____ R _____ | _____ |
| 2. Property Controlling in Section | S _____ T _____ R _____ | _____ |
| | S _____ T _____ R _____ | _____ |
| 3. Miscellaneous Property in Sec. | S _____ T _____ R _____ | _____ |
| | S _____ T _____ R _____ | _____ |

Recorded JUN 13 1995
9:00 A.M. at _____ o'clock _____ in _____ Book _____ Page 80
_____ Reg. of Deeds.
Delta County, Michigan
Register of Deeds Stamp & File Number

4. Lot No. _____, Recorded Plat _____
5. Private Claims D-9 [N1/4 COR S.29] D-11 [N1/4 COR S.32]

	A	B	C	D	E	F	G	H	I	J	K	L	M
2	6		5		4		3		2		1		
3													
4	7		8		9		10		11		12		
5													
6	18		17		16		15		14		13		
7													
8	19		20		21		22		23		24		
9													
10	30		29		28		27		26		25		
11													
12	31		32		33		34		35		36		
13													

I, W.P. DAVIS, in a field survey on MAY, 19 95, do hereby certify that under requirements of P.A. 74, Michigan P.A. of 1970, the corner points mentioned in lines 1 and 2 above were in conformance with regulations and rules therefore as required in the current manual of survey instructions of the United States Department of the Interior, Bureau of Land Management or by a decree of a Court of Law and/or that the corner points mentioned in lines 3, 4 and 5 above were in conformance with the rules of the Michigan Board of Land Surveyors or by a Decree of a Court of Law; established, re-established, monumented, re-monumented, recovered, found as expressed below:

NOTE: Not more than 4 corners, all in the same town and range, may be recorded on this certificate.

A. Description of original monument and accessories and/or subsequent restoration:


D-9 [N1/4 COR S.29] GEORGE ADAIR, D.S. - WOOD POST - 1852 - (HEMLOCK 13°-N33°W-28 LINKS) (CEDAR 18°-S33°E-28 LINKS)
NO RECORD EVIDENCE OF SUBSEQUENT CORNER RECOVERY OR MONUMENTATION

D-11 [N1/4 COR S.32] WOOD POST - GEORGE ADAIR, D.S. - 1852 (B.ASH 6°-N71°E-10 LINKS) (SPRUCE 11°-S72°W-40 LINKS)
NO RECORD EVIDENCE OF SUBSEQUENT CORNER RECOVERY OR MONUMENTATION

B. Description of corner evidence found and/or method applied in restoring or reestablishing corner:

D-9 [N1/4 COR S.29] FOUND IN PLACE A 1" I.P. - ID CORNER POSITION FROM EXISTING FARM FENCE TO THE NORTH & APPROX. C/L OF E-W COUNTY ROAD. MONUMENT AS FOUND IS 4.5' SOUTH & 1.32 WEST OF A DIRECT LINE BETWEEN CORNERS FOUND E & W. ACCEPTED EXISTING MONUMENT AS BEING THE BEST AVAILABLE EVIDENCE AS TO THE LOCATION OF THE POSITION OF THE ORIGINAL CORNER.

D-11 [N1/4 COR S.32] NO CORNER EVIDENCE FOUND. ESTABLISHED CORNER POSITION AT MIDPOINT BETWEEN SECTION CORNERS EAST & WEST.

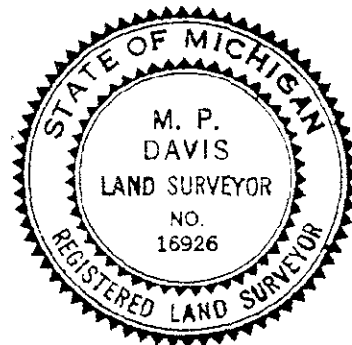

C. Description of monument for corner and accessories established to perpetuate locating the position of the corner:

D-9 SET OVER EXISTING MONUMENT A 5/8" X 18" REBAR & A 3 1/4" ALUMN CAP STAMPED TO ID THE CORNER POSITION.
 DRILL HOLE IN STONE SURVEY MONUMENT SIGN POST FARM LAND IN ALL QUADRANTS
 N33°E SOUTH NO OTHER WIT'S AVAILABLE
 53.87' 19.88' (TO FACE)

D-11 SET 5/8" X 18" REBAR & A 3 1/4" ALUMN CAP STAMPED TO ID THE COR POSITION, RAISED TO RD SURFACE W/A MONUMENT BOX
 SURVEY MONUMENT SIGN POST TAMARACK 5" TAMARACK 6" FARM LAND IN ALL QUADRANTS
 NORTH S30°E S51°W NO OTHER WIT'S AVAILABLE
 13.55' (TO FACE) 47.62' 63.79'

NOTE: BEARINGS TO REFERENCE OBJECTS ARE MAGNETIC - DISTANCES ARE TO A NAIL IN THE CENTER OF THE OBJECT UNLESS NOTED OTHERWISE

Signed by M.P. Davis Date 6/3/95
Surveyor's Michigan License No. 16926