

SURVEY & REMONUMENTATION

OCT 26 1995

COMMISSION

Approved by Delta County
Land Survey Remonumentation
Peer Group Under Act 345 Of
P.A. Of 1990 On June 6, 1995
Robert Blumelwicz
Acting Chairman

LAND CORNER RECORDATION CERTIFICATE
Filing Requirement of Act 74, Mich. P.A. 1970

For corners in

DELTA
(County)

Located In:

Corner Code ##

- | | | |
|------------------------------------|-----------------------------|-------------|
| 1. Public Land Survey | T <u>38 N</u> R <u>24 W</u> | <u>E-12</u> |
| | T _____ R _____ | _____ |
| | T _____ R _____ | _____ |
| | T _____ R _____ | _____ |
| 2. Property Controlling in Section | S _____ T _____ R _____ | _____ |
| | S _____ T _____ R _____ | _____ |
| 3. Miscellaneous Property in Sec. | S _____ T _____ R _____ | _____ |
| | S _____ T _____ R _____ | _____ |

Recorded 11/13 1995
9:00 A.M. # _____ of clock _____ in hour 8 Page 84
Robert Blumelwicz Reg. of Deeds
Delta County, Michigan
Register of Deeds Stamp & File Number

4. Lot No. _____, Recorded Plat _____
5. Private Claims _____
E-12 [W1/4 COR S.33]


A	B	C	D	E	F	G	H	I	J	K	L	M
2	6	5	4	3	2	1						
3												
4	7	8	9	10	11	12						
5												
6	18	17	16	15	14	13						
7												
8	19	20	21	22	23	24						
9												
10	30	29	28	27	26	25						
11												
12	31	32	33	34	35	36						
13												

I, M.P. DAVIS, in a field survey on MAY, 19 95, do hereby certify that under requirements of P.A. 74, Michigan P.A. of 1970, the corner points mentioned in lines 1 and 2 above were in conformance with regulations and rules therefore as required in the current manual of survey instructions of the United States Department of the Interior, Bureau of Land Management or by a decree of a Court of Law and/or that the corner points mentioned in lines 3, 4 and 5 above were in conformance with the rules of the Michigan Board of Land Surveyors or by a Decree of a Court of Law; established, re-established, monumented, re-monumented, recovered, found as expressed below:

NOTE: Not more than 4 corners, all in the same town and range, may be recorded on this certificate.

A. Description of original monument and accessories and/or subsequent restoration:
E-12 [W1/4 COR S.33] WOOD POST - GEORGE ADAIR, D.S. - 1852- (HEMLOCK 15"-N33°E-04 LINKS) (CEDAR 9"-S74°W-09) M.S. McNABB-1922-FOUND LARGE CEDAR STAKE IN PLACE (MAPLE 7"-EAST-14.25') (ASH 12"-N15°E-20.0')

B. Description of corner evidence found and/or method applied in restoring or reestablishing corner:
E-12 [W1/4 COR S.33] FOUND IN PLACE, AT JCT OF FENCE LINES N-S & WEST, AN AXEL SHAF? & THE REMAINS OF A CEDAR POST. ID EXISTING POST AS THE ONE FOUND IN PLACE IN 1922 BY M.S. McNABB BY McNABB'S MAPLE BT (EAST 14.25') WHICH IS STILL GREEN. ACCEPTED EXISTING MONUMENT AS BEING THE BEST AVAILABLE EVIDENCE AS TO THE POSITION OF THE ORIGINAL CORNER.

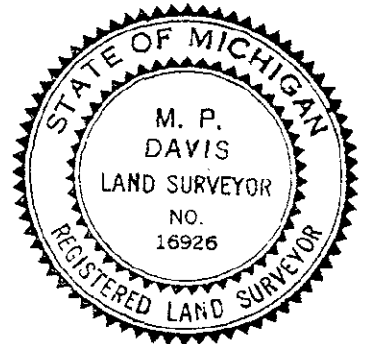

C. Description of monument for corner and accessories established to perpetuate locating the position of the corner:
E-12 REPLACED EXISTING WOOD POST W/A BERNTSEN AINB30 ALUMN MONUMENT WITH THE CAP STAMPED TO ID THE CORNER POSITION.

MAPLE 12"	MAPLE 13"	MAPLE 5"	CEDAR 13"	SURVEY MONUMENT SIGN POST
N16°E	S88°E	S28°W	N74°W	SOUTH
19.53'	14.25'	53.57'	33.72'	2.00' (TO FACE)

NOTE: BEARINGS TO REFERENCE OBJECTS ARE MAGNETIC - DISTANCES ARE TO A NAIL IN THE CENTER OF THE OBJECT UNLESS NOTED OTHERWISE

Signed by M.P. Davis Date 6/3/95

Surveyor's Michigan License No. 16926