

FEB 22 1996

COMMISSION

Approved by Delta County Land Survey Remonumentation Peer Group Under Act 345 Of P.A. Of 1990 On 1/17, 1996

LAND CORNER RECORDATION CERTIFICATE Filing Requirement of Act 74, Mich. P.A. 1970

Signature of M.P. Davis, Chairman

For corners in DELTA (County)

Located In: Corner Code #/

- 1. Public Land Survey T 38 N R 24 W F-3 F-5
2. Property Controlling in Section S T R
3. Miscellaneous Property in Sec. S T R

Recorded Jan 18 1996 at 9:00 o'clock AM in Liber 8 Page 118

Signature of W. C. Thoren, Reg. of Deeds, Delta County, Michigan

Register of Deeds Stamp & File Number

- 4. Lot No. Recorded Plat
5. Private Claims F-3 [N1/4 COR S.9] F-5 [N1/4 COR S.16]

Grid table with columns A-L and rows 2-13, showing section numbers and corner locations.

I, M.P. DAVIS, in a field survey on 6/94 & 12/95, 19 95, do hereby certify that under requirements of P.A. 74, Michigan P.A. of 1970, the corner points mentioned in lines 1 and 2 above were in conformance with regulations and rules therefore as required in the current manual of survey instructions of the United States Department of the Interior, Bureau of Land Management or by a decree of a Court of Law and/or that the corner points mentioned in lines 3, 4 and 5 above were in conformance with the rules of the Michigan Board of Land Surveyors or by a Decree of a Court of Law; established, re-established, monumented, re-monumented, recovered, found as expressed below:

NOTE: Not more than 4 corners, all in the same town and range, may be recorded on this certificate.

A. Description of original monument and accessories and/or subsequent restoration:


F-3 [N1/4 COR S.9] WOOD POST - GEORGE ADAIR, D.S. - 1852 - (HEMLOCK 20°-N66°E-21 LINKS) (Y. BIRCH 8°-S35°W-18) M.S. McNabb - 1933 - FROM DELTA COUNTY ROAD COMMISSION RECORDS - STAKE IN PLACE - NO WIT'S NOTED

F-5 [N1/4 COR S.16] WOOD POST - GEORGE ADAIR, D.S. - 1852 (HEMLOCK 11°-N59°E-35 LINKS) (TANARACK 11° -S63°W-08 LINKS) NO RECORD EVIDENCE OF SUBSEQUENT CORNER RECOVERY OR MONUMENTATION

B. Description of corner evidence found and/or method applied in restoring or reestablishing corner:

F-3 [N1/4 COR S.9] NO CORNER EVIDENCE FOUND. ESTABLISHED CORNER POSITION ON A STRAIGHT LINE AND PROPORTIONATE DISTANCE (BASED ON McNabb's 1933 MEASUREMENTS) BETWEEN SECTION CORNERS FOUND 1/2 MILE EAST AND WEST.

F-5 [N1/4 COR S.16] 1 1/2" IRON PIPE CORNER MONUMENT SHOWN TO ME BY MR. LARRY PEPIN, AREA RESIDENT, WHO STATED THAT THE IRON PIPE MONUMENT HAS ALWAYS BEEN RECOGNIZED AS THE CORNER. A TRAVERSE E & W TO ADJOINING CORNERS SHOWS THE EXISTING MONUMENT TO BE 1.62' NORTH & 1.46' WEST OF THE MIDPOINT BETWEEN CORNERS. NO EVIDENCE OF THE GLOBE FOUND. CORNER POSITION IS 20' NORTH OF A NW-SE WOODS ROAD. ACCEPTED EXISTING MONUMENT AS THE BEST AVAILABLE EVIDENCE AS TO THE LOCATION OF THE POSITION OF THE ORIGINAL CORNER.

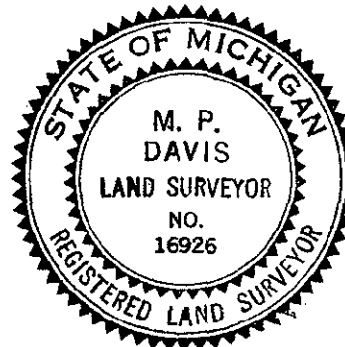

C. Description of monument for corner and accessories established to perpetuate locating the position of the corner:

F-3 SET 5/8" X 18" REBAR W/A 3/4" ALUMN CAP STAMPED TO ID THE CORNER POSITION & RAISED TO RD SURFACE W/A MONUMENT BOX CEDAR 7" RED PINE 8" POWER POLE SURVEY MONUMENT SIGN POST S33°E S55°W N45°W NORTH 61.70' 64.82' 37.19' (TO FACE) 15.25' (TO FACE)

F-5 SET, OVER EXISTING MONUMENT, A BERNTSEN ALNB30 ALUMN MONUMENT W/A 3/4" CAP STAMPED TO ID THE CORNER POSITION. W.PINE 15" W.PINE 15" MAPLE 6" W.PINE 21" SURVEY MONUMENT SIGN POST N88°W N70°E S63°E S43°W SOUTH 16.55' 40.70' 36.50' 51.94' 2.84' (TO FACE)

NOTE: BEARINGS TO REFERENCE OBJECTS ARE MAGNETIC - DISTANCES ARE TO A NAIL IN THE CENTER OF THE OBJECT UNLESS NOTED OTHERWISE

Signed by M.P. Davis Date JAN 8, 1996 Surveyor's Michigan License No. 10926