

REMONUMENTATION

FEB 22 1996

COMMISSION

LAND CORNER RECORDATION CERTIFICATE
Filing Requirement of Act 74, Mich. P.A. 1970

Approved By Delta County
Land Survey Remonumentation
Peer Group Under Act 345 Of
P.A. Of 1990 On 10/26, 1995
Robert Schumling
acting Chairman

For corners in
DELTA
(County)

Located In: Corner Code #

- 1. Public Land Survey T 38 N R 24 W F-11 & F-13
- T _____ R _____
- T _____ R _____
- T _____ R _____
- 2. Property Controlling S _____ T _____ R _____
- in Section S _____ T _____ R _____
- 3. Miscellaneous S _____ T _____ R _____
- Property in Sec. S _____ T _____ R _____

Recorded Oct 27 1995
at 9:00 o'clock AM in Liber 8 Page 106
Walter C. Thorne Reg. of Deeds.
Delta County, Michigan

Register of Deeds Stamp & File Number

- 4. Lot No. _____, Recorded Plat _____
- 5. Private Claims F-11 [N1/4 COR S.33] F-13 [S1/4 COR S.33-SAME AS F-01 T37N R24W] ✓

A	B	C	D	E	F	G	H	I	J	K	L	M
2	6	5	4	3	2	1						
3												
4	7	8	9	10	11	12						
5												
6	18	17	16	15	14	13						
7												
8	19	20	21	22	23	24						
9												
10	30	29	28	27	26	25						
11												
12	31	32	33	34	35	36						
13												

I, M.P. DAVIS, in a field survey on APRIL/MAY, 19 95, do hereby certify that under requirements of P.A. 74, Michigan P.A. of 1970, the corner points mentioned in lines 1 and 2 above were in conformance with regulations and rules therefore as required in the current manual of survey instructions of the United States Department of the Interior, Bureau of Land Management or by a decree of a Court of Law and/or that the corner points mentioned in lines 3, 4 and 5 above were in conformance with the rules of the Michigan Board of Land Surveyors or by a Decree of a Court of Law; established, re-established, monumented, re-monumented, recovered, found as expressed below:


NOTE: Not more than 4 corners, all in the same town and range, may be recorded on this certificate.

A. Description of original monument and accessories and/or subsequent restoration:

- F-11 [N1/4 COR S.33] WOOD POST - GEORGE ADAIR, D.S. - 1852- (BEECH 05°-N71°E-15 LINKS) (SUGAR 15°-S10°W-01)
M.S. McNABB-1917-ORIGINALS GONE, ESTABLISHED COR 1/2 DISTANCE BETWEEN COR'S (FENCE POST-N20°W-28') (MAIL BOX-S30°W-7.7')
M.S. McNABB-1920-AS SET PREVIOUS-DROVE IRON BOLT (FENCE POST-N35°W-24') (MAIL BOX-S30°W-15.2')
M.S. McNABB-1922-IRON BOLT FROM PREVIOUS SURVEY (COR FENCE POST-NORTH-19.8')
- F-13 [S1/4 COR S.33] WOOD POST - JAMES H. MULLETTE, D.S. - 1847 (CEDAR 09°-S87°E-13 LINKS) (SPRUCE 06° -N72°W-36 LINKS)
M.S. McNABB-1918-FOUND STAKE IN PLACE IDENTIFIED FROM ORIGINAL CEDAR BT (POPLAR-S30°W-19.7') (POPLAR-N30°E-31.7')
M.S. McNABB-1922- STAKE IN PLACE SET PREVIOUS (BALSAM STUMP 10°-N10°W-8') (CEDAR STUMP 8°-S55°W-33')

B. Description of corner evidence found and/or method applied in restoring or reestablishing corner:

- F-11 [N1/4 COR S.33] FOUND IN PLACE A 3/4" IRON PIN 20" BELOW COUNTY RD SURFACE. CORNER MONUMENT AS FOUND IS 14.46' NORTH & 5.56' WEST OF THE MID POINT BETWEEN CORNERS. AS THIS POSITION MATCHES McNABB'S REFERENCE TO THE FENCE TO THE NORTH & CHECKS WITH HIS DISTANCE WEST TO THE SECTION CORNER, I HAVE EXCEPTED THE EXISTING MONUMENT AS THAT BEING ESTABLISHED BY McNABB AS BEING A CAREFUL & FAITHFUL REESTABLISHMENT OF THE POSITION OF THE ORIGINAL CORNER.
- F-13 [S1/4 COR S.33] NO CORNER EVIDENCE FOUND. McNABB'S 1918 & 1922 BT'S HAVE APPARENTLY BEEN DESTROYED IN CONSTRUCTION OF E-W WOODS ROAD. RESET CORNER POSITION BY DISTANCE-DISTANCE INTERSECT, WEST FROM THE SE CORNER OF SEC 33 & SOUTH FROM THE N1/4 COR OF SEC 33, UTILIZING DISTANCES AS SHOWN IN McNABB'S RECORDS OF HIS 1922 PARTIAL SUBDIVISION OF SECTION 33. THIS POSITION FALLS 10' NORTH OF C/L OF E-W WOODS ROAD & 4.5' EAST OF OLD FENCE LINE TO THE NORTH. ACCEPTED THIS POSITION AS BEING A CAREFUL & FAITHFUL PERPETUATION OF THE POSITION OF THE ORIGINAL CORNER.

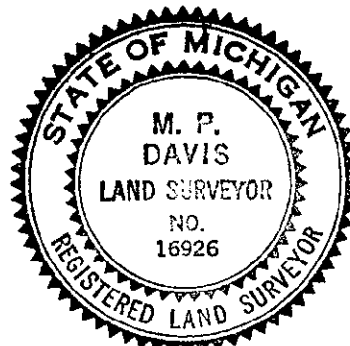

C. Description of monument for corner and accessories established to perpetuate locating the position of the corner:

- F-11 SET, OVER EXISTING MON, A 5/8" X 18" REBAR & A 3 1/4" ALUM CAP STAMPED TO ID THE COR POSITION & RAISED TO RD SURFACE W/A MON BOX

POWER POLE N05°W 28.29' (TO FACE)	SURVEY MONUMENT SIGN POST NORTH 22.29' (TO FACE)	POWER POLE S41°E 49.23' (TO FACE)	CORNER FENCE POST NORTH 37.10' (TO FACE)
---	--	---	--

- F-13 SET A BERNTSEN AINB30 ALUMN MONUMENT W/A 3 1/4" CAP STAMPED TO ID THE CORNER POSITION.

CEDAR 7" N10°W 12.82'	CEDAR 6" N79°E 54.90'	CEDAR 7" S31°E 47.92'	CEDAR 9" S33°W 55.40'	SURVEY MONUMENT SIGN POST WEST 1.90' (TO FACE)
-----------------------------	-----------------------------	-----------------------------	-----------------------------	--

NOTE: BEARINGS TO REFERENCE OBJECTS ARE MAGNETIC - DISTANCES ARE TO A NAIL IN THE CENTER OF THE OBJECT UNLESS NOTED OTHERWISE

Signed by M.P. Davis Date 10/24/95
Surveyor's Michigan License No. 16926