

OCT 26 1995 COMMISSION

Approved by Delta County Land Survey Remonumentation Peer Group Under Act 345 Of P.A. Of 1990 On June 6, 1995

LAND CORNER RECORDATION CERTIFICATE Filing Requirement of Act 74, Mich. P.A. 1970


For corners in DELTA (County)

Located In: Corner Code ##

Table with 4 columns: Item, Type (T/S), Direction (N/S), Distance, and Corner Code. Includes items for Public Land Survey, Property Controlling, and Miscellaneous Property.

Recorded JUN 13 1995 9:00 A.M. in Liber 8 Page 87 Delta County, Michigan Register of Deeds Stamp & File Number

4. Lot No. , Recorded Plat 5. Private Claims G-1 [NW COR S.3] G-2 [W1/4 COR S.3]

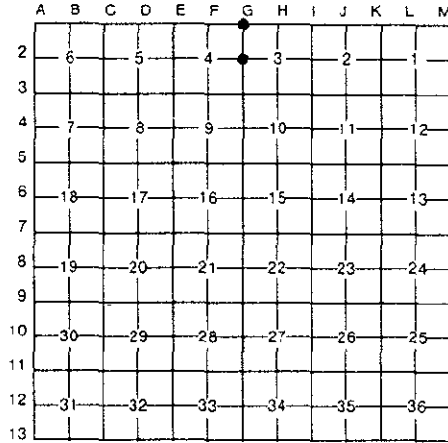

I, M.P. DAVIS, in a field survey on MAY/JUNE, 19 94, do hereby certify that under requirements of P.A. 74, Michigan P.A. of 1970, the corner points mentioned in lines 1 and 2 above were in conformance with regulations and rules therefore as required in the current manual of survey instructions of the United States Department of the Interior, Bureau of Land Management or by a decree of a Court of Law and/or that the corner points mentioned in lines 3, 4 and 5 above were in conformance with the rules of the Michigan Board of Land Surveyors or by a Decree of a Court of Law; established, re-established, monumented, re-monumented, recovered, found as expressed below:

NOTE: Not more than 4 corners, all in the same town and range, may be recorded on this certificate.

A. Description of original monument and accessories and/or subsequent restoration:

- G-1 [NW COR S.3] WOOD POST - JAMES H. MULLETTE, D.S. - 1848 (TAMARACK 15°-N59°E-36 LINKS) (SPRUCE 10°-N78°W-30 LINKS) GEORGE ADAIR, D.S. - 1852- WOOD POST (SPRUCE 08°-S75°E-22 LINKS) (CEDAR 08°-S40°W-22) M.DAVIS-1975-REESTABLISHED CORNER POSITION BY PROPORTIONATE DISTANCE N & S BETWEEN NW COR SEC 34 T38NR24W & SW COR SEC 3 T38NR24W & WEST FROM NW COR SEC 4 T38NR24W - BASED ON PREVIOUS SURVEYS OF RECORD. 1982-M.D.O.T. RECORDS-FOUND I.P. IN PLACE (ASH 4°-N65°W-44.07') (W.BIRCH 4°-S53°W-58.06') (W.BIRCH 3°-S53°E-47.7') (CEDAR 3°-S80°E-45.04') REC'D LIBER 5 OF LCR'S ON PAGE 98
G-2 [W1/4 COR S.3] WOOD POST - GEORGE ADAIR, D.S. - 1852 (TAMARACK 12°-N35°E-39 LINKS) (CEDAR 10° -S15°W-21 LINKS) M.DAVIS-1979-SET RR SPIKE-ESTABLISHED COR POSITION ON STRAIGHT LINE BETWEEN CORNERS N & S AND PROPORTIONATE DISTANCE BETWEEN THEM. 1982-M.D.O.T. RECORDS-FOUND TRACK SPIKE IN PLACE (POWER POLE-S20°E-58.55') (CEDAR 5°-N73°E-51.9') (CEDAR 13°-N32°W-72.86') (CEDAR 13°-N58°W-67.5') REC'D LIBER 2 OF LCR'S ON PAGE 99.

B. Description of corner evidence found and/or method applied in restoring or reestablishing corner:

- G-1 [NW COR S.3] RECOVERED I.P. IN MONUMENT BOX AS REC'D ABOVE - NO EVIDENCE OF M.D.O.T. WIT'S ACCEPTED EXISTING MONUMENT AS BEING THE BEST AVAILABLE EVIDENCE AS TO THE POSITION OF THE ORIGINAL CORNER.
G-2 [W1/4 COR S.3] RECOVERED IRON PIN IN MONUMENT BOX AS MENTIONED IN M.D.O.T. RECORDS ABOVE. ID FROM NW CEDAR BT, STILL GREEN. ACCEPTED EXISTING MONUMENT AS A CAREFUL & FAITHFUL REESTABLISHMENT OF THE POSITION OF THE ORIGINAL CORNER.



C. Description of monument for corner and accessories established to perpetuate locating the position of the corner:

- G-1 REPLACED I.P. W/A 5/8" X 18" REBAR W/A 3 1/4" ALUMN CAP STAMPED TO ID THE CORNER POSITION. CEDAR 8" TAMARACK 9" TAMARACK 7" SURVEY MONUMENT SIGN POST N37°W S86°E S22°E WEST 67.17' 47.74' 84.26' 26.05' (TO FACE)
G-2 REPLACED IRON PIN W/A 5/8" X 18" REBAR W/A 3 1/4" ALUMN CAP STAMPED TO ID THE CORNER POSITION. CEDAR 13" CEDAR 8" CEDAR 6" TELE POLE SURVEY MONUMENT SIGN POST N32°W N56°E S68°E WEST EAST 72.83' 55.65' 54.81' 37.59' (TO FACE) 8.46' (TO FACE)

NOTE: BEARINGS TO REFERENCE OBJECTS ARE MAGNETIC - DISTANCES ARE TO A NAIL IN THE CENTER OF THE OBJECT UNLESS NOTED OTHERWISE

Signed by M.P. Davis Date 6/3/95 Surveyor's Michigan License No. 16926