

CONVENTION
REMONUMENTATION

FEB 22 1996

COMMISSION

LAND CORNER RECORDATION CERTIFICATE
Filing Requirement of Act 74, Mich. P.A. 1970

Approved By Delta County
Land Survey Remonumentation
Peer Group Under Act 345 Of
P.A. Of 1990 On 1/17, 1996

Robert Helmeberg
Acting Chairman

For corners in
DELTA
(County)

Located In: Corner Code #

1. Public Land Survey	T	38 N	R	24 W	G-5	G-6
	T		R			
	T		R			
	T		R			
2. Property Controlling in Section	S		T	R		
	S		T	R		
3. Miscellaneous Property in Sec.	S		T	R		
	S		T	R		

Recorded Jan 18 1996
at 9:00 o'clock AM in Liber 8 Page 121
Walter C. Zeman Reg. of Deeds.
Delta County, Michigan

Register of Deeds Stamp & File Number

4. Lot No. _____, Recorded Plat _____
5. Private Claims G-5 [NW COR S.15] G-6 [W1/4 COR S.15]

A	B	C	D	E	F	G	H	I	J	K	L	M
2	6	5	4	3	2	1						
3												
4	7	8	9	10	11	12						
5												
6	18	17	16	15	14	13						
7												
8	19	20	21	22	23	24						
9												
10	30	29	28	27	26	25						
11												
12	31	32	33	34	35	36						
13												

I, M.P. DAVIS, in a field survey on DECEMBER, 19 95, do hereby certify that under requirements of P.A. 74, Michigan P.A. of 1970, the corner points mentioned in lines 1 and 2 above were in conformance with regulations and rules therefore as required in the current manual of survey instructions of the United States Department of the Interior, Bureau of Land Management or by a decree of a Court of Law and/or that the corner points mentioned in lines 3, 4 and 5 above were in conformance with the rules of the Michigan Board of Land Surveyors or by a Decree of a Court of Law; established, re-established, monumented, re-monumented, recovered, found as expressed below:

NOTE: Not more than 4 corners, all in the same town and range, may be recorded on this certificate.

A. Description of original monument and accessories and/or subsequent restoration:


G-5 [NW COR S.15] GEORGE ADAIR, D.S. - 1852 - WOOD POST - (SPRUCE 10" - N42°E - 10 LINKS) (W.PINE 12" - S32°W - 21) NO RECORD EVIDENCE OF SUBSEQUENT CORNER RECOVERY OR CORNER MONUMENTATION

G-6 [W1/4 COR S.15] GEORGE ADAIR, D.S. - 1852 - WOOD POST - (CEDAR 08" - N64°W - 07 LINKS) (SPRUCE 08" - S38°E - 24 LINKS) NO RECORD EVIDENCE OF SUBSEQUENT CORNER RECOVERY OR CORNER MONUMENTATION

B. Description of corner evidence found and/or method applied in restoring or reestablishing corner:

G-5 [NW COR S.15] FOUND IN PLACE A STEEL FENCE POST AT THE JCT. OF ANCIENT FENCE LINES N-S & W NOW DOWN AND IN POOR CONDITION. POSSIBLE "GLO" W.PINE BT SW, NOW DOWN & DETERIORATED BEYOND IDENTIFICATION, REMAINS OF STUMP FITS WELL WITH "GLO" POSITION FROM STEEL FENCE POST. ACCEPTED EXISTING MONUMENT AS BEING THE BEST AVAILABLE EVIDENCE AS TO THE LOCATION OF THE POSITION OF THE ORIGINAL CORNER.

G-6 [W1/4 COR S.15] NO CORNER EVIDENCE FOUND. ESTABLISHED CORNER POSITION AT MIDPOINT BETWEEN SECTION SECTION CORNERS 1/2 MILE NORTH & SOUTH. THIS POSITION FITS WELL WITH "GLO" TERRAIN CALL TO TOP OF RIDGE TO THE NORTH.

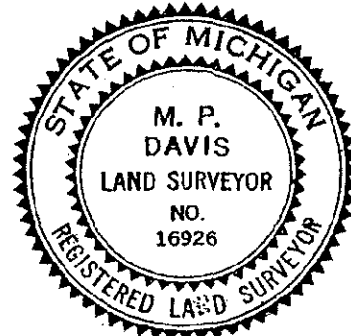

C. Description of monument for corner and accessories established to perpetuate locating the position of the corner:

G-5 SET, OVER EXISTING FENCE POST, A BERNTSEN AINB30 ALUMN MONUMENT W/A 3 1/4" CAP STAMPED TO ID THE CORNER POSITION.
CEDAR 5" CEDAR 5" CEDAR 5" CEDAR 5" SURVEY MONUMENT SIGN POST
N70°W N30°E S60°E S15°W NORTH
5.48' 15.45' 9.42' 11.67' 1.75' (TO FACE)

G-6 SET A BERNTSEN AINB30 ALUMN MONUMENT W/A 3 1/4" CAP STAMPED TO ID THE CORNER POSITION.
CEDAR 6" CEDAR 5" CEDAR 6" CEDAR 4" SURVEY MONUMENT SIGN POST
N70°W N52°E S63°E S19°W NORTH
10.72' 10.34' 17.30' 12.02' 2.60' (TO FACE)

NOTE: BEARINGS TO REFERENCE OBJECTS ARE MAGNETIC - DISTANCES ARE TO A NAIL IN THE CENTER OF THE OBJECT UNLESS NOTED OTHERWISE

Signed by M.P. Davis Date JAN 8, 1996

Surveyor's Michigan License No. 16926