

Approved By Delta County
Land Survey Remonumentation
Peer Group Under Act 345 Of
P.A. Of 1990 On May 12, 1994

Robert Schumeling
Acting Chairman

LAND CORNER RECORDATION CERTIFICATE
Filing Requirement of Act 74, Mich. P.A. 1970

For corners in
DELTA
(County)

Located In: Corner Code #

- | | | |
|------------------------------------|-----------------------------|----------------|
| 1. Public Land Survey | T <u>38</u> N R <u>24</u> W | <u>L-3</u> L-5 |
| | T _____ R _____ | _____ |
| | T _____ R _____ | _____ |
| | T _____ R _____ | _____ |
| 2. Property Controlling in Section | S _____ T _____ R _____ | _____ |
| | S _____ T _____ R _____ | _____ |
| 3. Miscellaneous Property in Sec. | S _____ T _____ R _____ | _____ |
| | S _____ T _____ R _____ | _____ |

MAY 13 1994

Recorded _____
at 9:00 o'clock AM in Liber 7 Page 395
William C. Thum Reg. of Deeds.
Delta County, Michigan
Register of Deeds Stamp & File Number

4. Lot No. _____, Recorded Plat _____
5. Private Claims L-3 [N1/4 COR S.12] L-5 [N1/4 COR S.13]

	A	B	C	D	E	F	G	H	I	J	K	L	N
2	6		5		4		3		2		1		
3													
4	7		8		9		10		11		12		
5													
6	18		17		16		15		14		13		
7													
8	19		20		21		22		23		24		
9													
10	30		29		28		27		26		25		
11													
12	31		32		33		34		35		36		
13													

I, M.P. DAVIS, in a field survey on APRIL, 19 94, do hereby certify that under requirements of P.A. 74, Michigan P.A. of 1970, the corner points mentioned in lines 1 and 2 above were in conformance with regulations and rules therefore as required in the current manual of survey instructions of the United States Department of the Interior, Bureau of Land Management or by a decree of a Court of Law and/or that the corner points mentioned in lines 3, 4 and 5 above were in conformance with the rules of the Michigan Board of Land Surveyors or by a Decree of a Court of Law; established, re-established, monumented, re-monumented, recovered, found as expressed below:


NOTE: Not more than 4 corners, all in the same town and range, may be recorded on this certificate.

A. Description of original monument and accessories and/or subsequent restoration:
L-3 [N1/4 COR S.12] GEORGE ADAIR, D.S. - 1852 - WOOD POST - (SUGAR 18°-N50°E-35 LINKS) (SUGAR 18°-S78°W-27 LINKS)
M.DAVIS-1977-FOUND IRON BOLT IN PLACE-IDENTIFIED CORNER POSITION FROM OCCUPATION & IMPROVEMENTS

L-5 [N1/4 COR S.13] GEORGE ADAIR, D.S. - 1852 - WOOD POST - (TAMARACK 07°-N04°W-08 LINKS) (TAMARACK 10°-S10°E-10 LINKS)
NO RECORD EVIDENCE OF SUBSEQUENT CORNER RECOVERY OR MONUMENTATION

B. Description of corner evidence found and/or method applied in restoring or reestablishing corner:
L-3 [N1/4 COR S.12] FOUND, 20" M/L BELOW ROAD SURFACE, THE ABOVE MENTIONED IRON BOLT AND ACCEPTED THE SAME AS BEING THE BEST AVAILABLE EVIDENCE AS THE POSITION OF THE ORIGINAL CORNER.

L-5 [N1/4 COR S.13] NO CORNER EVIDENCE FOUND. ESTABLISHED NEW POSITION AT MIDPOINT BETWEEN SECTION CORNERS E & W.

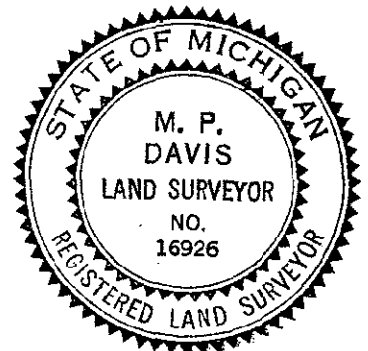

- C. Description of monument for corner and accessories established to perpetuate locating the position of the corner:
- L-3 SET OVER EXISTING MON & 6" M/L BELOW ROAD SURFACE A 5/8" X 18" REBAR W/A 3-1/4" ALUMN CAP STAMPED TO ID THE CORNER POSITION.
- | | | | |
|-------------------------|-----------|------------------|---------------------------|
| W.BIRCH (SHADE TREE) | MAPLE 24" | POWER POLE | SURVEY MONUMENT SIGN POST |
| N62°W | N77°E | S72°W | S33°E |
| 55.67' (TO C/L-NO NAIL) | 75.80' | 39.74' (TO FACE) | 18.32' (TO FACE) |
- L-5 SET, 6" M/L BELOW ROAD SURFACE, A 5/8" X 18" REBAR W/A 3-1/4" ALUMN CAP STAMPED TO ID THE CORNER POSITION.
- | | | | | |
|----------------|----------------|-----------|----------------|---------------------------|
| WHITE BIRCH 5" | WHITE BIRCH 6' | CEDAR 10" | WHITE BIRCH 8" | SURVEY MONUMENT SIGN POST |
| N53°W | N47°E | S28°E | S30°W | SOUTH |
| 55.33' | 44.05' | 51.08' | 54.17' | 23.10' (TO FACE) |

NOTE: BEARINGS TO REFERENCE OBJECTS ARE MAGNETIC - DISTANCES ARE TO A NAIL IN THE CENTER OF THE OBJECT UNLESS NOTED OTHERWISE

Signed by M.P. Davis Date 5/6/94
Surveyor's Michigan License No. 16926