

REMONUMENTATION

FEB 22 1996

COMMISSION

LAND CORNER RECORDATION CERTIFICATE  
Filing Requirement of Act 74, Mich. P.A. 1970

Approved By Delta County  
Land Survey Remonumentation  
Peer Group Under Act 345 Of  
P.A. Of 1990 On 10/26, 1995  
Robert Schumling  
Acting Chairman

For corners in  
DELTA  
(County)

Located In: Corner Code #

- 1. Public Land Survey T 38 N R 24 W M-6 M-7
- T \_\_\_\_\_ R \_\_\_\_\_
- T \_\_\_\_\_ R \_\_\_\_\_
- T \_\_\_\_\_ R \_\_\_\_\_
- 2. Property Controlling S \_\_\_\_\_ T \_\_\_\_\_ R \_\_\_\_\_
- in Section S \_\_\_\_\_ T \_\_\_\_\_ R \_\_\_\_\_
- 3. Miscellaneous S \_\_\_\_\_ T \_\_\_\_\_ R \_\_\_\_\_
- Property in Sec. S \_\_\_\_\_ T \_\_\_\_\_ R \_\_\_\_\_

Recorded Oct 27 1995  
at 9:00 o'clock AM in Liber 8 Page 108  
William C. Thayer Reg. of Deeds.  
Delta County, Michigan

Register of Deeds Stamp & File Number

- 4. Lot No. \_\_\_\_\_, Recorded Plat \_\_\_\_\_
- 5. Private Claims \_\_\_\_\_  
M-6 [E1/4 COR S.13] M-7 [NE COR S.24] (SAME AS A-6 & A-7 T38N R23W)

	A	B	C	D	E	F	G	H	I	J	K	L	M
2	6	5	4	3	2	1							
3													
4	7	8	9	10	11	12							
5													
6	18	17	16	15	14	13							
7													
8	19	20	21	22	23	24							
9													
10	30	29	28	27	26	25							
11													
12	31	32	33	34	35	36							
13													

I, M.P. DAVIS, in a field survey on SEPTEMBER, 19 95, do hereby certify that under requirements of P.A. 74, Michigan P.A. of 1970, the corner points mentioned in lines 1 and 2 above were in conformance with regulations and rules therefore as required in the current manual of survey instructions of the United States Department of the Interior, Bureau of Land Management or by a decree of a Court of Law and/or that the corner points mentioned in lines 3, 4 and 5 above were in conformance with the rules of the Michigan Board of Land Surveyors or by a Decree of a Court of Law; established, re-established, monumented, re-monumented, recovered, found as expressed below:

NOTE: Not more than 4 corners, all in the same town and range, may be recorded on this certificate.

A. Description of original monument and accessories and/or subsequent restoration:


M-6 [E1/4 COR S.13] JOHN BURT, D.S. - 1845 - WOOD POST - (TAMARACK 05°-S40°W-06 LINKS) (W.PINE 05°-N40°W-25 LINKS)  
NO RECORD EVIDENCE OF SUBSEQUENT CORNER RECOVERY OR MONUMENTATION

M-7 [NE COR S.24] JOHN BURT, D.S. - 1845 - WOOD POST - (W.PINE 30° S70°W-17 LINKS) (HEMLOCK 06°-N37°W-35 LINKS)  
A. MERRYWEATHER, D.S. - 1847 - WOOD POST - (HEMLOCK 12°-N50°E-22 LINKS) (HEMLOCK 06°-S30°E-05 LINKS) from survey of T38N R23W  
NO RECORD EVIDENCE OF SUBSEQUENT CORNER RECOVERY OR MONUMENTATION

B. Description of corner evidence found and/or method applied in restoring or reestablishing corner:

M-6 [E1/4 COR S.13] NO ORIGINAL CORNER EVIDENCE FOUND & NO IDENTIFIABLE INDICATION OF SUBSEQUENT CORNER RESTORATION FOUND. REESTABLISHED CORNER POSITION AT MIDPOINT BETWEEN BETWEEN SECTION CORNERS 1/2 MILE NORTH & SOUTH.

M-7 [NE COR S.24] FOUND IN PLACE A 1 1/4" I.P. W/A 3" STAMPED OCTOGONAL BRASS CAP ATTACHED THERE TO & THE REMAINS OF A 4" SQ'D WOOD POST, FROM WHICH A PINE STUMP BEARS S.70°W-11.82' WITH THE MEASURING NOTCH CLEARLY IDENTIFIABLE. THE EXISTING BRASS CAP IS NOT DATED NOR DOES IT CONTAIN THE NAME OF THE SCRIVNER. DID NOT DISTURB EXISTING MONUMENT AND ACCEPTED THE SAME AS BEING A CAREFUL & FAITHFUL PERPETUATION OF THE POSITION OF THE ORIGINAL CORNER.

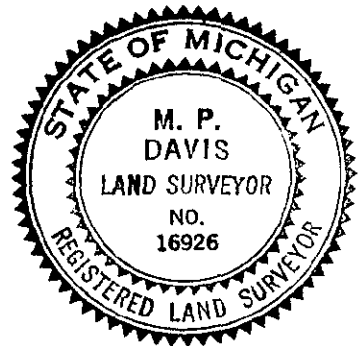

C. Description of monument for corner and accessories established to perpetuate locating the position of the corner:

M-6 SET BERNTSEN ALNB30 ALUMN MONUMENT W/A 3 1/4" CAP STAMPED TO ID THE CORNER POSITION.  
WHITE PINE 8" CEDAR 4" CEDAR 4" WHITE PINE 4" SURVEY MONUMENT SIGN POST  
N29°W N13°E S18°E S35°W EAST  
40.24' 12.16' 2.01' 25.97' 3.00' (TO FACE)

M-7 DID NOT DISTURB EXISTING MONUMENT  
HEMLOCK 12" HEMLOCK 16" (OLD SIG. TREE) RED PINE 14" HEMLOCK 11" SURVEY MONUMENT SIGN POST  
N38°W N40°E S25°E S73°W WEST  
22.55' 10.90' 17.92' 14.10' 2.38' (TO FACE)

NOTE: BEARINGS TO REFERENCE OBJECTS ARE MAGNETIC - DISTANCES ARE TO A NAIL IN THE CENTER OF THE OBJECT UNLESS NOTED OTHERWISE

Signed by M.P. Davis Date 10/24/95  
Surveyor's Michigan License No. 16926