

JAN 25 2000

SECTION

Approved By Delta County  
Land Survey Remonumentation  
Peer Group Under Act 345 Of  
P.A. Of 1990 On Dec 28, 1999

LAND CORNER RECORDATION CERTIFICATE  
Filing Requirement of Act 74, Mich. P.A. 1970

*Robert Schmaling*  
*Acting Chairman*

For corners in

<u>DELTA</u> (County)	Located In:	Corner Code #
1. Public Land Survey	T 39 N R 18 W	A-09 SAME
	T 39 N R 19 W	M-09 CORNERS
	T 39 N R 18 W	A-10 SAME ✓
	T 39 N R 19 W	M-10 CORNERS
2. Property Controlling in Section	S ___ T ___ R ___	_____
	S ___ T ___ R ___	_____
3. Miscellaneous Property in Sec.	S ___ T ___ R ___	_____
	S ___ T ___ R ___	_____

A-09 [NE COR SEC 30] A-10 [W1/4 SEC 30]

01-04-00  
2:00 O'CLOCK PM  
9 PAGE 190  
*Walton C. Thorne*  
REGISTERED SURVEYOR

Register of Deeds Stamp & File Number

4. Lot No. \_\_\_\_\_, Recorded Plat \_\_\_\_\_  
5. Private Claims \_\_\_\_\_

I, M.P. DAVIS, in a field survey on NOVEMBER, 19 99 do hereby state that under requirements of P.A. 74, Michigan P.A. of 1970, the corner points mentioned in lines 1 and 2 above were in conformance with regulations and rules therefore as required in the current manual of survey instructions of the United States Department of the Interior, Bureau of Land Management or by a decree of a Court of Law and /or that the corner points mentioned in lines 3, 4 and 5 above were in conformance with the rules of the Michigan Board of Land Surveyors or by a Decree of a Court of Law; established, re-established, monumented, recovered, found as expressed below:

	A	B	C	D	E	F	G	H	I	J	K	L	M
1													
2	6		5		4		3		2		1		
3													
4	7		8		9		10		11		12		
5													
6	18		17		16		15		14		13		
7													
8	19		20		21		22		23		24		
9													
10	30		29		28		27		26		25		
11													
12	31		32		33		34		35		36		
13													

NOTE: Not more than 2 corners, all in the same town and range, may be recorded on this certificate.

A. Description of original monument and accessories and/or subsequent restoration:

- A-09 [NE COR SEC 30] JOHN BURT, D.S.-1845-WOOD POST (SUGAR 07" N27°W 26 LINKS)(LYNN 16" S10°W 24 LINKS) A.MERRYWEATHER, D.S.-1848-WOOD POST (CEDAR 11" N28°E 12 LINKS)(CEDAR 10" S74°E 11 LINKS) NO RECORD EVIDENCE OF CORNER RECOVERY AND/OR SUBSEQUENT MONUMENTATION
- A-10 [W1/4 COR SEC 30] JOHN BURT, D.S.-1845- WOOD POST (ASPEN 12" N42°W 17 LINKS)(CEDAR 05" S50°W 05 LINKS) M.S.McNABB-1946-SEVERAL SQUARED TREES AND OLD STAKE-MARKED AND SET NEW STAKE (BALM GILEAD 8" S20°E 11')(ASH 06" N56°E 14.50'

B. Description of corner evidence found and/or method applied in restoring or reestablishing corner:


- A-09 [NE COR SEC 30] NO CORNER EVIDENCE FOUND.RESTORED CORNER POSITION BY SINGLE PROPORTIONATE MEASUREMENT BETWEEN 1/4 CORNERS 1/2 MILE NORTH AND SOUTH.
- A-10 [W1/4 COR SEC 30] FOUND IN PLACE, AT NORTH BASE OF 18" WHITE BIRCH, THE REMAINS OF A SQUARED CEDAR POST. ID MONUMENT AS BEING THE SAME AS SET BY McNABB IN 1946 FROM HIS ASH BT NE, NOW AN 18" STUMP WITH LOWER BLAZE PLAIN. THE BALM GILEAD BT IS NOW A WELL DETERIORATED STUMP IDENTIFIABLE ONLY BY ITS' RELATIONSHIP TO THE EXISTING MONUMENT. ACCEPTED EXISTING CORNER AS BEING THE BEST AVAILABLE EVIDENCE AS TO THE POSITION OF THE ORIGINAL CORNER.

C. Description of monument for corner and accessories established to perpetuate locating the position of the corner:

- A-09 SET A BERNTSEN A1NB30 ALUM MONUMENT WITH THE CAP STAMPED TO ID THE CORNER POSITION.  

ASH 05"	ASH 09"	ASH 07"	ASH 08"	ASH 08"	SURVEY MONUMENT SIGN POST
N73°W	N45°W	EAST	S27°E	S42°W.	NORTH
13.20'	47.30'	30.68'	18.28'	25.13'	2.00' (TO FACE)
- A-10 REPLACE EXISTING MONUMENT WITH A BERNTSEN A1NB30 ALUM MONUMENT WITH THE CAP STAMPED TO ID THE CORNER POSITION.  

ASH 07"	CEDAR 08"	CEDAR 09"	SURVEY MONUMENT SIGN POST
N59°E	S41°E	S34°W	EAST
20.48'	26.50'	38.24'	0.85 (TO FACE)

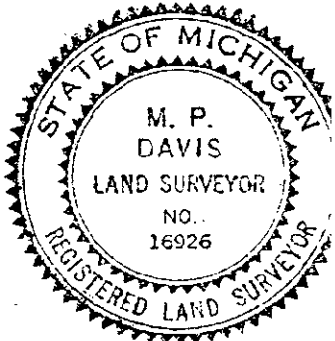

NOTE: BEARINGS TO REFERENCE OBJECTS ARE MAGNETIC-DISTANCES ARE TO A NAIL W/A DELTA COUNTY REFERECNE TAG, UNLESS OTHERWISE NOTED.

Signed by M.P. Davis Date 12/20/99  
Surveyor's Michigan License No. 16926