

JAN 25 2000

Approved By Delta County
Land Survey Remonumentation
Peer Group Under Act 345 Of
P.A. Of 1990 On Dec 28, 1999

SECTION

LAND CORNER RECORDATION CERTIFICATE
Filing Requirement of Act 74, Mich. P.A. 1970

Philip A. Schmeider
Acting Chairman

For corners in

| DELTA (County) | Located In: | Corner Code # |
|---------------------------------------|--|--|
| 1. Public Land Survey | T 39 N R 18 W T 39 N R 19 W T 39 N R 18 W T 39 N R 19 W | A-11 SAME M-11 CORNERS A-12 SAME ✓ M-12 CORNERS |
| 2. Property Controlling in Section | S ___ T ___ R ___ S ___ T ___ R ___ | _____ _____ |
| 3. Miscellaneous Property in Sec. | S ___ T ___ R ___ S ___ T ___ R ___ | _____ _____ |

01-04-00
2:00 O'CLOCK PM
PAGE 9 PAGE 189
William C. Thomas
Register of Deeds Stamp & File Number

4. Lot No. _____, Recorded Plat _____
5. Private Claims _____

I, M.P. DAVIS, in a field survey on NOVEMBER, 1999 do hereby state that under requirements of P.A. 74, Michigan P.A. of 1970, the corner points mentioned in lines 1 and 2 above were in conformance with regulations and rules therefore as required in the current manual of survey instructions of the United States Department of the Interior, Bureau of Land Management or by a decree of a Court of Law and /or that the corner points mentioned in lines 3, 4 and 5 above were in conformance with the rules of the Michigan Board of Land Surveyors or by a Decree of a Court of Law; established, re-established, monumented, recovered, found as expressed below:


| | | | | | | | | | | | | |
|----|----|----|----|----|----|----|---|---|---|---|---|---|
| A | B | C | D | E | F | G | H | I | J | K | L | M |
| 1 | | | | | | | | | | | | |
| 2 | 6 | 5 | 4 | 3 | 2 | 1 | | | | | | |
| 3 | | | | | | | | | | | | |
| 4 | 7 | 8 | 9 | 10 | 11 | 12 | | | | | | |
| 5 | | | | | | | | | | | | |
| 6 | 18 | 17 | 16 | 15 | 14 | 13 | | | | | | |
| 7 | | | | | | | | | | | | |
| 8 | 19 | 20 | 21 | 22 | 23 | 24 | | | | | | |
| 9 | | | | | | | | | | | | |
| 10 | 30 | 29 | 28 | 27 | 26 | 25 | | | | | | |
| 11 | | | | | | | | | | | | |
| 12 | 31 | 32 | 33 | 34 | 35 | 36 | | | | | | |
| 13 | | | | | | | | | | | | |

NOTE: Not more than 2 corners, all in the same town and range, may be recorded on this certificate.

A. Description of original monument and accessories and/or subsequent restoration:
A-11 [NE COR SEC 31] JOHN BURT, D.S.-1845-WOOD POST (ASPEN 09" N52°W 26 LINKS)(TAMARACK 08" S20°W 14 LINKS)
A.MERRYWEATHER, D.S.-1848-WOOD POST (POPLAR 12" N60°E 19 LINKS)(BALSAM 04" S26°E 03 LINKS)
M.S.McNABB-1946-FOUND STAKE IN PLACE, MARKED 25,30,36,31-SET NEW STAKE AND NOTED THE FOLLOWING BT'S (ASH 11" N50°W 4.70')(CEDAR 7" S40°E 13.4').

A-12 [W1/4 COR SEC 31] JOHN BURT, D.S.-1845- WOOD POST (HEMLOCK 09" N61°W 15 LINKS)(CEDAR 18" S31°W 32 LINKS)
NO RECORD EVIDENCE OF CORNER RECOVERY AND/OR SUBSEQUENT MONUMENTATION

B. Description of corner evidence found and/or method applied in restoring or reestablishing corner:
A-11 [NE COR SEC 31] FOUND IN PLACE THE REMAINS OF A SQUARED CEDAR POST. ID CORNER MONUMENT AS THE SAME AS HAVING BEEN SET BY M.S.McNABB IN 1946, FROM HIS BT'S NOW BOTH STUMPS, WITH LOWER BLAZE AND IRON MARKS PLAIN ON THE ASH BT. ACCEPTED EXISTING MONUMENT AS BEING THE BEST AVAILABLE EVIDENCE AS TO THE LOCATION OF THE POSITION OF THE ORIGINAL CORNER.
A-12 [W1/4 COR SEC 31] NO CORNER EVIDENCE FOUND. THIS AREA HAS RECENTLY BEEN CLEAR CUT IN ALL FOUR QUADRANTS. REESTABLISHED CORNER POSITION AT MIDPOINT AND ON LINE WITH THE SECTION CORNERS 1/2 MILE TO THE NORTH AND SOUTH.

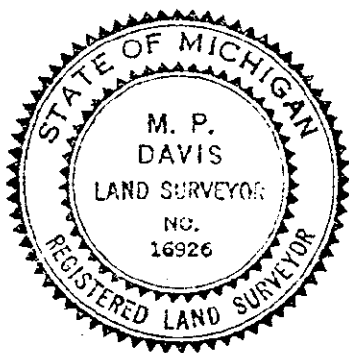

C. Description of monument for corner and accessories established to perpetuate locating the position of the corner:
A-11 REPLACED EXISTING MONUMENT W/A BERNTSEN A1NB30 ALUM MONUMENT WITH THE CAP STAMPED TO ID THE CORNER POSITION.
CEDAR 10" ASH 07" CEDAR 08" CEDAR 09" SURVEY MONUMENT SIGN POST
N61°W N59°E S41°E S34°W EAST
55.50' 20.48' 26.50' 38.24' 0.00' (TO FACE)
A-12 SET A BERNTSEN A1NB30 ALUM MONUMENT WITH THE CAP STAMPED TO ID THE CORNER POSITION.
ELM 05" 3 LEGGED CEDAR STUMP 3' HIGH BALSAM 05" SURVEY MONUMENT SIGN POST
N75°W N33°E S48°W EAST
26.25' 39.72' 19.47' 1.28 (TO FACE)

NOTE: BEARINGS TO REFERENCE OBJECTS ARE MAGNETIC-DISTANCES ARE TO A NAIL W/A DELTA COUNTY REFERECNE TAG, UNLESS OTHERWISE NOTED.

Signed by M.P. Davis Date 12/20/99
Surveyor's Michigan License No. 16926