

JAN 1 2000

SECTION

LAND CORNER RECORDATION CERTIFICATE
Filing Requirement of Act 74, Mich. P.A. 1970

Approved by Delta County
Land Survey Remonumentation
Peer Group Under Act 345 Of
P.A. Of 1990 On 3-3, 1999
David B. Ballitt
Chairman

For corners in
DELTA
(County)


Located In: Corner Code #

Table with 3 columns: Item description, Located In (T, R, S, N, W, E, S, T, R), and Corner Code #. Includes items like Public Land Survey, Property Controlling in Section, and Miscellaneous Property in Sec.

Handwritten registration stamp: Mar 4 1999, 9:00 AM, Page 139, signed by Walter C. Thomas, Delta County, Michigan Deeds.

Register of Deeds Stamp & File Number

4. Lot No. Recorded Plat
5. Private Claims B-3 [N1/4 COR SEC 7] B-7 [N1/4 COR SEC 19]

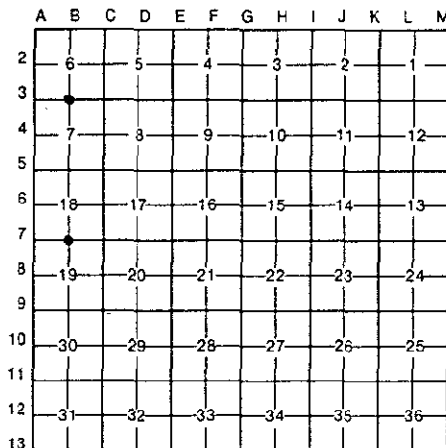

I, M.P. DAVIS, in a field survey on FEBRUARY, 1999, do hereby certify that under requirements of P.A. 74, Michigan P.A. of 1970, the corner points mentioned in lines 1 and 2 above were in conformance with regulations and rules therefore as required in the current manual of survey instructions of the United States Department of the Interior, Bureau of Land Management or by a decree of a Court of Law and/or that the corner points mentioned in lines 3, 4 and 5 above were in conformance with the rules of the Michigan Board of Land Surveyors or by a Decree of a Court of Law; established, re-established, monumented, re-monumented, recovered, found as expressed below:

NOTE: Not more than 4 corners, all in the same town and range, may be recorded on this certificate.

A. Description of original monument and accessories and/or subsequent restoration:


B-3 [N1/4 COR SEC. 7] A.MERRYWEATHER, DS - 1848 - WOOD POST - (BEECH 07° N35°W 29 LINKS)(BEECH 04° S20°E 24 LINKS) M.DAVIS RLS-1973-L.1 PG.403 LCR'S-FOUND IN PLACE 1" I.P. (1" I.P. IN CONC MON NORTH 21.46')(C/L MAPLE 6" N30°E 50.3')

B-7 [N1/4 COR SEC 19] A.MERRYWEATHER,D.S. - 1848 - (BEECH 10° N54°W 20 LINKS) (MAPLE 07° S62°E-10 LINKS) M.DAVIS RLS-1981-FOUND IN PLACE NAIL AS SET BY T.O'BRIEN DATE UNKNOWN-REPLACED W/A 1" I.P. & RAISED TO GRADE W/A MON BOX - (C/L PP S2°E 36.1)(FENCE POST IN CONC S31°W 40.55')(STOP SIGN POST N21°E 49.77') NEIL HILL RLS-1986-L.6 PG.104 LCR'S-REPLACED I.P. W/A 1/2" REBAR (PP SOUTH 35.94')(4" X 4" DNR SIGN POST N70°E 75.64')(ANCHOR FENCE POST N5°W 36.92')(FENCE POST N55°W 69.17')

B. Description of corner evidence found and/or method applied in restoring or reestablishing corner:

B-3 [N1/4 COR SEC. 7] FOUND IN PLACE A 1" IRON PIPE BY PERSONS UNKNOWN. ID CORNER MONUMENT AS BEING THE SAME AS FOUND BY MYSELF IN 1973 FROM CONC MONUMENT BT TO THE NORTH, NOW BROKEN AND INCLINED HEAVILY TO THE SOUTH. THIS MONUMENT FITS WELL WITH LOCAL OCCUPATION AND CORRESPONDS WITH EXISTING PROPERTY DESCRIPTIONS. ACCEPTED EXISTING MONUMENT AS BEING THE BEST AVAILABLE EVIDENCE AS TO THE LOCATION OF THE POSITION OF THE ORIGINAL CORNER.

B-7 [N1/4 COR SEC 19] FOUND IN PLACE AND INSIDE A MONUMENT BOX A 1/2" REBAR. ID CORNER MONUMENT FROM BT'S RECORDED AT L.6 OF LCR'S PG.104. CORNER POSITION FITS WELL WITH EXISTING OCCUPATION AND PROPERTY DESCRIPTIONS. ACCEPTED ESISTING MONUMENT AS BEING THE BEST AVAILABLE EVIDENCE AS TO THE POSITION OF THE ORIGINAL CORNER.

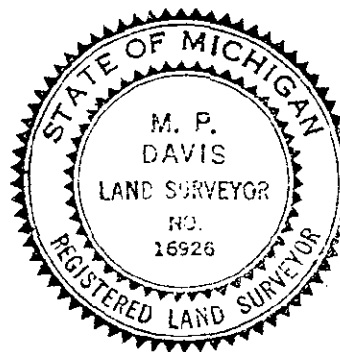

C. Description of monument for corner and accessories established to perpetuate locating the position of the corner:

B-3 SET OVER EXISTING MONUMENT A 5/8" X 18" REBAR W/A 3 1/4" ALUM CAP STAMPED TO ID THE CORNER POSITION. IRONWOOD 05° MAPLE 07° MAPLE 08° SURVEY MONUMENT SIGN POST N43°W N47°E S12°E SOUTH 37.80' 50.11' 68.25' 27.75' (TO FACE)

B-7 REPLACED EXISTING MONUMENT W/A 5/8" X 18" REBAR W/A 3 1/4" CAP STAMPED TO ID THE CORNER POSITION. HWY. C/L P.I. POWER POLE C/L IRON FENCE POST SURVEY MONUMENT SIGN POST S85°E SOUTH S34°W NORTH SOUTH 64.82' 35.94' 40.60' 31.85' (TO FACE)

NOTE: BEARINGS TO REFERENCE OBJECTS ARE MAGNETIC-DISTANCES ARE TO A NAIL W/A DELTA COUNTY REFERENCE TAG, UNLESS OTHERWISE NOTED.

Signed by M.P. Davis Date 2/15/99
Surveyor's Michigan License No. 16926