

JAN 5 2000

SECTION

LAND CORNER RECORDATION CERTIFICATE
Filing Requirement of Act 74, Mich. P.A. 1970

Approved By Delta County
Land Survey Remonumentation
Peer Group Under Act 345 Of
P.A. Of 1990 On 3-3, 1999
Chairman

For corners in
DELTA
(County)


Located In: Corner Code #

Table with 3 columns: Item description, Located In (T, R, S, N, W, E, S, T, R), and Corner Code #. Includes items like Public Land Survey, Property Controlling in Section, etc.

REGISTERED Mar 4 1999
9:00 AM
9 140
Walter C. Thoman

Register of Deeds Stamp & File Number

- 4. Lot No. , Recorded Plat
5. Private Claims C-2 [W1/4 COR SEC 5] C-3 [NW COR SEC 8]

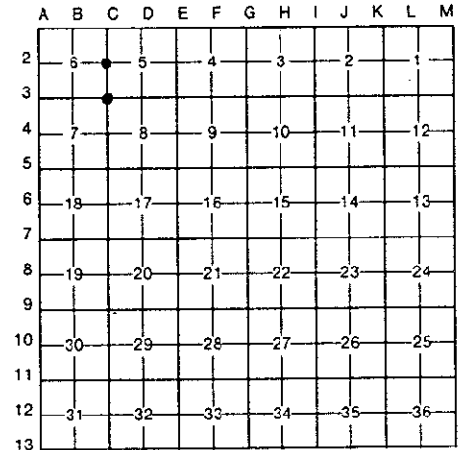

I, M.P. DAVIS, in a field survey on FEBRUARY, 19 99, do hereby certify that under requirements of P.A. 74, Michigan P.A. of 1970, the corner points mentioned in lines 1 and 2 above were in conformance with regulations and rules therefore as required in the current manual of survey instructions of the United States Department of the Interior, Bureau of Land Management or by a decree of a Court of Law and/or that the corner points mentioned in lines 3, 4 and 5 above were in conformance with the rules of the Michigan Board of Land Surveyors or by a Decree of a Court of Law; established, re-established, monumented, re-monumented, recovered, found as expressed below:

NOTE: Not more than 4 corners, all in the same town and range, may be recorded on this certificate.

A. Description of original monument and accessories and/or subsequent restoration:


C-2 [W1/4 COR SEC. 5] A.MERRYWEATHER, DS - 1848 - WOOD POST - (SUGAR 12" N40°E 15 LINKS)(BEECH 06" S30°W 13 LINKS) M.DAVIS-1972-L.1 PG.29 LCR'S-SET CONC PLAT MON-(COTTON WOOD 4" S13°E 63.80')(SPRUCE 11" S88°E 66.9')

C-3 [NW COR SEC 8] A.MERRYWEATHER, D.S. - 1848 - (HEMLOCK 30" N60°W 34 LINKS) (IRONWOOD 04" S30°E-14 LINKS) M.DAVIS-1972-L.1 PG.23 LCR'S-FOUND IN PLACE A 1" IRON BAR, SET BY PERSONS UNKNOWN, ON NORTH EDGE OF E-W COUNTY ROAD (PP S70°W 107.8')(C/L E-W COUNTY RD SOUTH 8')

B. Description of corner evidence found and/or method applied in restoring or reestablishing corner:

C-2 [W1/4 COR SEC. 5] FOUND IN PLACE A 1/2" REBAR ENCASED IN A 4" X 4" X 36" CONCRETE MONUMENT AS SET BY MYSELF IN 1972 AND RECORDED IN LIBER 1 OF LCR'S PG 29. ID EXISTING MONUMENT FROM 1972 SPRUCE BT SE STILL GREEN. ACCEPTED EXISTING MONUMENT AS BEING THE BEST AVAILABLE EVIDENCE AS TO THE LOCATION OF THE POSITION OF THE ORIGINAL CORNER.

C-3 [NW COR SEC 8] FOUND IN PLACE A 1" IRON BAR. ID CORNER MONUMENT AS BEING THE SAME MONUMENT FOUND BY MYSELF IN 1972 FROM BT'S RECORDED AT L.1 OF LCR'S PG.23. ACCEPTED EXISTING MONUMENT AS BEING THE BEST AVAILABLE EVIDENCE AS TO THE LOCATION OF THE POSITION OF THE ORIGINAL CORNER.

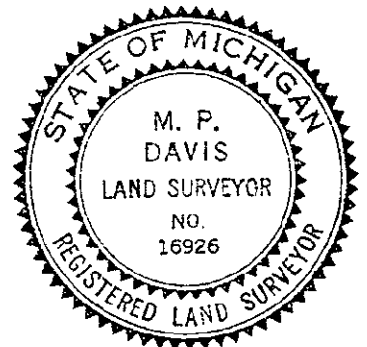

C. Description of monument for corner and accessories established to perpetuate locating the position of the corner:

C-2 REPLACED EXISTING MONUMENT W/A BERNTSEN A1NB30 ALUM MONUMENT WITH A 3 1/4" CAP STAMPED TO ID THE CORNER POSITION. SPRUCE 16" (OLD BT) ASH 10" SPLIT ASH 10" C/L OF E-W PRIVATE RDWAY SURVEY MONUMENT SIGN POST. BEARINGS: S88°E, S27°E, S32°W, NORTH, SOUTH. DISTANCES: 66.88', 46.35', 27.83', 45'±, 1.34' (TO FACE)

C-3 SET OVER EXISTING MONUMENT A BERN'SEN A1NB30 ALUMN MON. W/A 3 1/4" CAP STAMPED TO ID THE CORNER POSITION. 5/8"x18" REBAR W/A 2" ALUM WIT. CAP C/L COUNTY RD POWER POLE W. BIRCH TWIN SURVEY MONUMENT SIGN POST. BEARINGS: N45°W, SOUTH, S53°W, N37°E, NORTH. DISTANCES: 21.75', 8'±, 61.45', 74.90', 1.85' (TO FACE)

NOTE: BEARINGS TO REFERENCE OBJECTS ARE MAGNETIC-DISTANCES ARE TO A NAIL W/A DELTA COUNTY REFERENCE TAG, UNLESS OTHERWISE NOTED.

Signed by M.P. Davis Date 2/22/99
Surveyor's Michigan License No. 16926