

JAN 2000

SECTION

LAND CORNER RECORDATION CERTIFICATE
Filing Requirement of Act 74, Mich. P.A. 1970

Approved by Delta County
Land Survey Remonumentation
Peer Group Under Act 345 Of
P.A. Of 1990 On 3-3, 1999
David B. Robbitt
Chairman

For corners in

DELTA
(County)

Located In:

Corner Code ##

- 1. Public Land Survey T 39 N R 18 W D-3
T 39 N R 18 W D-5
2. Property Controlling in Section S T R
3. Miscellaneous Property in Sec. S T R

Mar 4 1999
9:00 AM
9 144
Walter E. Zeman

Register of Deeds Stamp & File Number

- 4. Lot No. Recorded Plat
5. Private Claims

D-3 [N1/4 COR SEC 8] D-2 [N1/4 COR SEC 17]

I, M.P. DAVIS, in a field survey on FEBRUARY, 19 99, do hereby certify that under requirements of P.A. 74, Michigan P.A. of 1970, the corner points mentioned in lines 1 and 2 above were in conformance with regulations and rules therefore as required in the current manual of survey instructions of the United States Department of the Interior, Bureau of Land Management or by a decree of a Court of Law and/or that the corner points mentioned in lines 3, 4 and 5 above were in conformance with the rules of the Michigan Board of Land Surveyors or by a Decree of a Court of Law; established, re-established, monumented, re-monumented, recovered, found as expressed below:

NOTE: Not more than 4 corners, all in the same town and range, may be recorded on this certificate.


Grid table with columns A-M and rows 2-13. Contains numerical data points for survey locations.

A. Description of original monument and accessories and/or subsequent restoration:

- D-3 [N1/4 COR SEC. 8] A.MERRYWEATHER, DS - 1848 - IRONWOOD 04' CORNER TREE (SUGAR 22" WEST 02 LINKS)
M.S.McNABB-1916-ROAD ALIGNMENT SURVEY- COUNTY ROAD 483-IRON STAKE IN PLACE 34' WEST OF C/L NO WIT'S NOTED
M.DAVIS, RLS-1970-FD IN PLACE A 1" IRON BAR 34' WEST OF C.R. 483 C/L (NO WIT'S NEAR)
NEIL HILL, RLS-1986-L.6 PG. 119 LCR'S-FD IRON BAR 35' WEST OF C/L-SET MON BOX-FENCE POST SOUTH 34.51')(SIGN POST N5'E 35.18')(SW COR BLDG N65'E 90.10')
D-5 [N1/4 COR SEC 17] A.MERRYWEATHER, DS-1848-SET WOOD POST-(BASSWOOD 12" N10'W 18 LINKS)(BEECH 06" S20'E 34 LINKS)
M.S.McNABB-1923-ID BY IRON GAS PIPE IN ROAD (TP N35'W 35.3)(COR FENCE POST S40'W 41.0')
M.DAVIS, RLS-1975-L.1 PG. 405 LCR'S-FD IN PLACE RR SPIKE/I.P. ID FROM STUB OF McNABB'S TP BT (SW COR BLDG NELY 73.8')(TP N35'W 36')
NEIL HILL, RLS-1986-L.6 PG. 116 LCR'S-FD RR SPIKE (TP N25'W 36.02')(CHISELED SQ N50'E 62.96')(PP S80'W 126.62')

B. Description of corner evidence found and/or method applied in restoring or reestablishing corner:

- D-3 [N1/4 COR SEC. 8] FOUND IN PLACE AND INSIDE A MONUMENT BOX A 3/4" IRON PIN 35 1/2 WEST OF THE C/L OF HWY. M-183. ID CORNER MONUMENT FROM BT'S REC'D AT L.6 OF LCR'S PG.119. ACCEPTED EXISTING MONUMENT AS BEING THE BEST AVAILABLE EVIDENCE AS TO THE LOCATION OF THE POSITION OF THE ORIGINAL CORNER.
D-5 [N1/4 COR SEC 17] FOUND IN PLACE AND INSIDE A MONUMENT BOX A 1/2" IRON ROD. ID CORNER MONUMENT FROM BT'S REC'D AT L.6 & L.7 OF LCR'S PG'S. 116 & 234 RESPECTIVELY. ACCEPTED EXISTING MONUMENT AS BEING THE BEST AVAILABLE EVIDENCE AS TO THE LOCATION OF THE POSITION OF THE ORIGINAL CORNER.

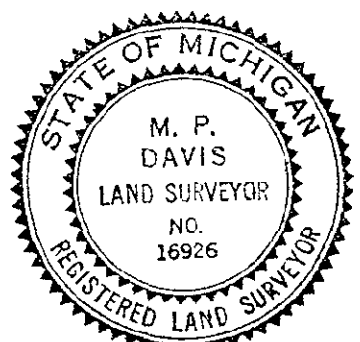

C. Description of monument for corner and accessories established to perpetuate locating the position of the corner:

- D-3 REPLACED EXISTING MONUMENT W/A 5/8" X 18" REBAR W/A 3 1/4" ALUM CAP STAMPED TO ID THE CORNER POSITION.
2 1/2" GALV RD SIGN POST SW CORNER OF HOUSE POWER POLE SURVEY MONUMENT SIGN POST
N21'E N70'E S60'E SOUTH
32.55' 90.30' 74.52' 24.86' (TO FACE)
D-5 REPLACED EXISTING MONUMENT W/A 5/8" X 18" REBAR W/A 3 1/4" ALUM CAP STAMPED TO ID THE CORNER POSITION.
NOTE: WIT'S SHOWN AT L.6 & L.7 OF LCR'S PG'S 116 & 234 RESPECTIVELY ARE STILL IN PLACE AND VIABLE.

NOTE: BEARINGS TO REFERENCE OBJECTS ARE MAGNETIC-DISTANCES ARE TO A NAIL W/A DELTA COUNTY REFERENCE TAG, UNLESS OTHERWISE NOTED.

Signed by M.P. Davis Date 2/15/99
Surveyor's Michigan License No. 16926