

2000

SECTION

LAND CORNER RECORDATION CERTIFICATE
Filing Requirement of Act 74, Mich. P.A. 1970

Approved By Delta County
Land Survey Remonumentation
Peer Group Under Act 345 Of
P.A. Of 1990 On 3-3, 1999
David B. Bobbitt
Chairman

For corners in

DELTA

(County)

Located In:

Corner Code ##

Table with 3 columns: Item description, Located In (S, T, R), and Corner Code. Includes items for Public Land Survey, Property Controlling in Section, and Miscellaneous Property in Sec.

Stamp: Mar 4 1999
9:00 AM
9
145
William C. Thomas

Register of Deeds Stamp & File Number

4. Lot No. , Recorded Plat
5. Private Claims

D-6 [C1/4 COR SEC 17] D-7 [N1/4 COR SEC 20]

I, M.P. DAVIS, in a field survey on FEBRUARY, 19 99, do hereby certify that under requirements of P.A. 74, Michigan P.A. of 1970, the corner points mentioned in lines 1 and 2 above were in conformance with regulations and rules therefore as required in the current manual of survey instructions of the United States Department of the Interior, Bureau of Land Management or by a decree of a Court of Law and/or that the corner points mentioned in lines 3, 4 and 5 above were in conformance with the rules of the Michigan Board of Land Surveyors or by a Decree of a Court of Law; established, re-established, monumented, re-monumented, recovered, found as expressed below:

Grid table with columns A-M and rows 2-13. Contains numerical data points for survey locations.

NOTE: Not more than 4 corners, all in the same town and range, may be recorded on this certificate.

A. Description of original monument and accessories and/or subsequent restoration:

D-6 [C1/4 COR SEC. 17] NOT SET IN ORIGINALS

M.S. McNABB-1923-IRON PIPE & OLD TAMARACK 8" BT (DEAD) S82°W 34.5' IN PLACE (CEDAR 4" S50°E 65.0')(CEDAR 4" S73°W 21.3')
M.S. McNABB-1924-REFERENCED AS P.O.B. PLAT OF VILLAGE OF GARDEN SUBDIVISION L. "B" OF PLATS PG 44


D-7 [N1/4 COR SEC 20] A.MERRYWEATHER, DS-1848-SET WOOD POST-(BASSWOOD 12" N10°W 18 LINKS)(BEECH 06" S20°E 34 LINKS)

JOHN CRAIG-1900-RESET 1/2 DISTANCE BETWEEN CORNERS-CORNER FENCE POST S51°W 34')(FENCE POST S45°E 47.5')
NEIL HILL, RLS-1986-L.6 PG.106 LCR'S-FD 3/8" IRON ROD (SE COR TOMBSTONE S50°W 90.35')(W.BIRCH 25' N55°E 54.71')(PP S35' 39.61')(FENCE POST N35°E 65.75')

B. Description of corner evidence found and/or method applied in restoring or reestablishing corner:

D-6 [C1/4 COR SEC. 17] FOUND IN PLACE A 3/4" IRON PIPE. ID MONUMENT AS BEING THE SAME AS THAT FOUND BY McNABB IN 1923 FROM BOTH OF HIS CEDAR BT'S (NOW STUMPS) IRON MARKS ON THE SE BT ARE STILL PLAIN.

D-7 [N1/4 COR SEC 20] FOUND IN PLACE A 3/8" IRON PIN. ID CORNER MONUMENT FROM BT'S REC'D IN L.6 OF LCR'S PG.106. ACCEPTED EXISTING MONUMENT AS BEING THE BEST AVAILABLE EVIDENCE AT TO THE LOCATION OF THE POSITION OF THE ORIGINAL CORNER.

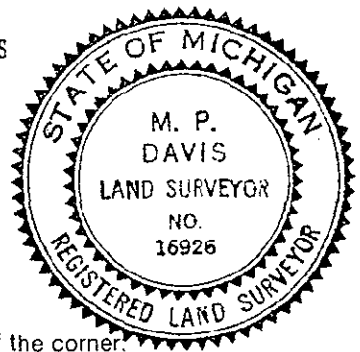

C. Description of monument for corner and accessories established to perpetuate locating the position of the corner:

D-6 SET, OVER EXISTING MONUMENT, A BERNTSEN AINB30 ALUM MONUMENT W/A 3 1/4" CAP STAMPED TO ID THE CORNER POSITION.

CEDAR 13" CEDAR 11" SURVEY MONUMENT SIGN POST
N65°W S73°W SOUTH
11.52' 22.26' 1.46' (TO FACE)

D-7 SET, OVER EXISTING MONUMENT, A 5/8" X 18' REBAR W/A 3 1/4" ALUM CAP STAMPED TO ID THE CORNER POSITION.

5/8" X 18' REBAR W/A 2" ALUM WIT CAP SURVEY MONUMENT SIGN POST NOTE: ALL WIT'S SHOWN AT L.6 OF LCR'S ARE IN PLACE AND VIABLE.
N56°W N48°E
69.02' 49.41' (TO FACE)

NOTE: BEARINGS TO REFERENCE OBJECTS ARE MAGNETIC-DISTANCES ARE TO A NAIL W/A DELTA COUNTY REFERENCE TAG, UNLESS OTHERWISE NOTED.

Signed by M.P. Davis Date 2/15/99

Surveyor's Michigan License No. 16926