

JAN 13 2000

SECTION

LAND CORNER RECORDATION CERTIFICATE
Filing Requirement of Act 74, Mich. P.A. 1970

Approved By Delta County
Land Survey Remonumentation
Peer Group Under Act 345 Of
P.A. Of 1990 On 3-3, 1999
David B. Bobbitt
Chairman

For corners in

Table with columns: DELTA (County), Located In:, Corner Code ##. Rows include Public Land Survey, Property Controlling in Section, Miscellaneous Property in Sec.

Mar 4 1999
9:00 AM
9 146
William A. Plummer

Register of Deeds Stamp & File Number

- 4. Lot No.
5. Private Claims

D-9 [N1/4 COR SEC 29] D-10 [C1/4 COR SEC 29]

I, M.P. DAVIS, in a field survey on FEBRUARY, 1999, do hereby certify that under requirements of P.A. 74, Michigan P.A. of 1970, the corner points mentioned in lines 1 and 2 above were in conformance with regulations and rules therefore as required in the current manual of survey instructions of the United States Department of the Interior, Bureau of Land Management or by a decree of a Court of Law and/or that the corner points mentioned in lines 3, 4 and 5 above were in conformance with the rules of the Michigan Board of Land Surveyors or by a Decree of a Court of Law; established, re-established, monumented, re-monumented, recovered, found as expressed below:

Grid table with columns A-M and rows 2-13. A dot is marked at the intersection of column C and row 10.

NOTE: Not more than 4 corners, all in the same town and range, may be recorded on this certificate.

A. Description of original monument and accessories and/or subsequent restoration:


D-9 [N1/4 COR SEC. 29] A.NERRYWEATHER, DS-1848-SET WOOD POST (BEECH 08' N31'E 39 LINKS)(HEMLOCK 10" S02'W 24 LINKS) W.BOWMAN, RLS-1989-L.6 PG.120 LCR'S-SET 1/2" IRON BAR W/A SURVEY CAP AT MIDDPOINT & ON LINE WITH SEC CORN'S 1/2 MILES E & W. (COR FENCE POST N42'W 54.5')(FENCE POST S42'W 53.9')(NW COR CONC WATER TROUGH S77'E 34.9')

D-10 [C1/4 COR SEC 29] NOT SET IN ORIGINALS
M.DAVIS, RLS - 1998 - SET 5/8" X 18" IRON PIN W/A ID CAP AT JCT OF N-W & E-W 1/4 LINES.
NO WIT'S NOTED

B. Description of corner evidence found and/or method applied in restoring or reestablishing corner:

D-9 [N1/4 COR SEC. 29] FOUND IN PLACE A 1/2" IRON BAR W/A PLASTIC ID CAP. ID CORNER MONUMENT FROM BT'S REC'D AT L.6 OF LCR'S PG.120. ACCEPTED EXISTING MONUMENT AS BEING A CAREFUL AND FAITHFUL REESTABLISHMENT OF THE POSITION OF THE ORIGINAL CORNER.

D-10 [C1/4 COR SEC 29] FOUND IN PLACE 5/8" X 18" IRON PIN AS SET BY MYSELF IN 1998.

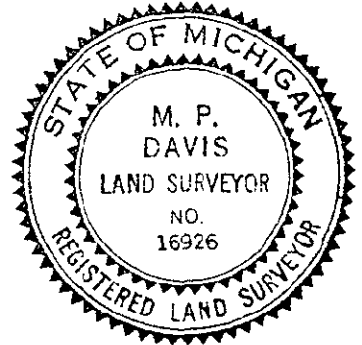

C. Description of monument for corner and accessories established to perpetuate locating the position of the corner:

D-9 REPLACED EXISTING MONUMENT W/A 5/8" X 18" REBAR W/A 3/4" ALUM CAP STAMPED TO ID THE CORNER POSITION. SURVEY MONUMENT SIGN POST NOTE: BT'S REC'D AT L.6 OF LCR'S PG.120 EAST ARE STILL IN PLACE AND VIABLE. 25.70' (TO FACE)

D-10 REPLACED ID CAP W/A 3/4" ALUM CAP STAMPED TO ID THE CORNER POSITION. CEDAR 03" 5/8"X18" REBAR W/A 2" ALUM WIT CAP POWER POLE SURVEY MONUMENT SIGN POST N19'W S45'E S55'W EAST 53.69' 22.46' 44.02' 11.15' (TO FACE)

NOTE: BEARINGS TO REFERENCE OBJECTS ARE MAGNETIC-DISTANCES ARE TO A NAIL W/A DELTA COUNTY REFERENCE TAG, UNLESS OTHERWISE NOTED.

Signed by M.P. Davis Date 2/15/99

Surveyor's Michigan License No. 16926