

JAN 4 1999

SECTION

Approved By Delta County
Land Survey Remonumentation
Peer Group Under Act 345 Of
P.A. Of 1990 On 3-3, 1999

David B. Ballitt
Chairman

LAND CORNER RECORDATION CERTIFICATE
Filing Requirement of Act 74, Mich. P.A. 1970

For corners in
DELTA
(County)

Located In: Corner Code #

- 1. Public Land Survey

T 39 N R 18 W		E - 1 SAME
T 40 N R 18 W		E - 13 CORNER
T 39 N R 18 W		E - 2 ✓
T _____ R _____		
- 2. Property Controlling in Section

S _____ T _____ R _____		
S _____ T _____ R _____		
- 3. Miscellaneous Property in Sec.

S _____ T _____ R _____		
S _____ T _____ R _____		

Recorded Mar 4 1999
at 9:00 AM
File # 9 137
William C. Thomas
Clerk of Deeds, All Reg. of Deeds

Register of Deeds Stamp & File Number

- 4. Lot No. _____, Recorded Plat _____
- 5. Private Claims _____

E-1 [NW COR SEC 4] E-2 [W1/4 COR SEC 4]

I, M.P. DAVIS, in a field survey on FEBRUARY, 19 99, do hereby certify that under requirements of P.A. 74, Michigan P.A. of 1970, the corner points mentioned in lines 1 and 2 above were in conformance with regulations and rules therefore as required in the current manual of survey instructions of the United States Department of the Interior, Bureau of Land Management or by a decree of a Court of Law and/or that the corner points mentioned in lines 3, 4 and 5 above were in conformance with the rules of the Michigan Board of Land Surveyors or by a Decree of a Court of Law; established, re-established, monumented, re-monumented, recovered, found as expressed below:

	A	B	C	D	E	F	G	H	I	J	K	L	M
2	6	5	4	3	2	1							
3													
4	7	8	9	10	11	12							
5													
6	13	17	16	15	14	13							
7													
8	19	20	21	22	23	24							
9													
10	30	29	28	27	26	25							
11													
12	31	32	33	34	35	36							
13													


NOTE: Not more than 4 corners, all in the same town and range, may be recorded on this certificate.

A. Description of original monument and accessories and/or subsequent restoration:

- E-1 [NW COR SEC. 4] JOHN BURT, DS-1845-SET WOOD POST (CEDAR 06" N14°E 25 LINKS)(CEDAR 22" N68°W 19 LINKS)
A.MERRYWEATHER, DS-1848-(CEDAR 12" S40°E 31 LINKS)(CEDAR 18" S56°W 32 LINKS)
M.S.McNABB-DATE UNKNOWN-IRON IN PLACE AT FENCE COR-FENCE E-W & S-RD SOUTH ALL ON WEST SIDE
FRANK BRAY, RLS-1970-L.4 PG.213 LCR'S-FD IRON ROD AT FENCE CORNER-FENCE LINES N-S & E-W NO OTHER WIT'S NOTED
- E-2 [W1/4 COR SEC 4] A.MERRYWEATHER, DS-1848-SET WOOD POST-(BEECH 10" N51°W 23 LINKS)(BALSAM 07" S52°E 21 LINKS)
M.DAVIS, RLS-1972-L.1 PG.22 LCR'S-FOUND IN PLACE STONE/IRON PIN AT JCT OF FENCE LINES N-S & E-W BY PERSONS UNKNOWN

B. Description of corner evidence found and/or method applied in restoring or reestablishing corner:

- E-1 [NW COR SEC. 4] FOUND IN PLACE AT THE JCT OF FARM FENCES N-S & E-W A 1" IRON PIPE AS DESCRIBED AT L.4 OF LCR'S PG.213. THIS MONUMENT CHECKS WELL FOR POSITIONAL MEASUREMENTS TO 1/16 & 1/4 CORNERS FOUND IN PLACE TO THE SOUTH. ACCEPTED EXISTING MONUMENT AS BEING THE BEST AVAILABLE EVIDENCE AS TO THE LOCATION OF THE POSITION OF THE ORIGINAL CORNER.
- E-2 [W1/4 COR SEC 29] FOUND IN PLACE A 1" IRON PIN. ID CORNER MONUMENT AS BEING THE SAME AS FOUND BY MYSELF IN 1972 AND REC'D IN L.1 OF LCR'S PG.22. THIS MONUMENT CHECKS WELL WITH POSITIONAL MEASUREMENTS TO ADJOINING CORNERS FOUND TO THE NORTH & SOUTH AND FITS WELL WITH EXISTING OCCUPATION. ACCEPTED EXISTING MONUMENT AS BEING THE BEST AVAILABLE EVIDENCE AS TO THE LOCATION OF THE POSITION OF THE ORIGINAL CORNER.

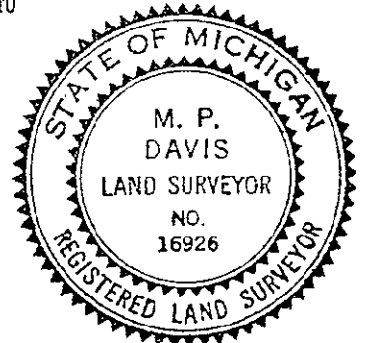

C. Description of monument for corner and accessories established to perpetuate locating the position of the corner:

- E-1 SET, OVER EXISTING MONUMENT, A BERNTSEN A1NB30 ALUM MONUMENT W/A 3 1/4" CAP STAMPED TO ID THE CORNER POSITION.
CORNER FENCE POST SURVEY MONUMENT SIGN POST NOTE: FARM FIELDS IN ALL FOUR QUADRANTS.
N56°W NORTH NO OTHER WIT'S AVAILABLE.
1.60' (TO FACE) 0.91' (TO FACE)
- E-2 SET, OVER EXISTING MONUMENT, A BERNTSEN A1NB30 ALUMN MON. W/A 3 1/4" CAP STAMPED TO ID THE CORNER POSITION.
N-S FENCE LINE FENCE LINE EAST FENCE LINE WEST DRILL HOLE IN LARGE ROCK SURVEY MONUMENT SIGN POST
EAST NORTH SOUTH SOUTH WEST
2'± 6'± 8'± 22.90' 0.84' (TO FACE)

NOTE: BEARINGS TO REFERENCE OBJECTS ARE MAGNETIC-DISTANCES ARE TO A NAIL W/A DELTA COUNTY REFERENCE TAG, UNLESS OTHERWISE NOTED.

Signed by M.P. Davis Date 2/15/99
Surveyor's Michigan License No. 16926