

JAN 4 1999

SECTION

LAND CORNER RECORDATION CERTIFICATE
Filing Requirement of Act 74, Mich. P.A. 1970

Approved by Delta County
Land Survey Remonumentation
Peer Group Under Act 345 Of
P.A. Of 1990 On 3-3, 1999
David B. Bobbitt
Chairman

Table with columns: For corners in DELTA (County), Located In: (Town, Range, Section), Corner Code #. Includes entries for Public Land Survey and Property Controlling in Section.


RECORDED Mar 4 1999
9:00 AM
9 147
Walter C. Thomas

Register of Deeds Stamp & File Number

4. Lot No. , Recorded Plat
5. Private Claims

E-3 [NW COR SEC 9] E-4 [W1/4 COR SEC 9]


I, M.P. DAVIS, in a field survey on FEBRUARY, 1999, do hereby certify that under requirements of P.A. 74, Michigan P.A. of 1970, the corner points mentioned in lines 1 and 2 above were in conformance with regulations and rules therefore as required in the current manual of survey instructions of the United States Department of the Interior, Bureau of Land Management or by a decree of a Court of Law and/or that the corner points mentioned in lines 3, 4 and 5 above were in conformance with the rules of the Michigan Board of Land Surveyors or by a Decree of a Court of Law; established, re-established, monumented, re-monumented, recovered, found as expressed below:

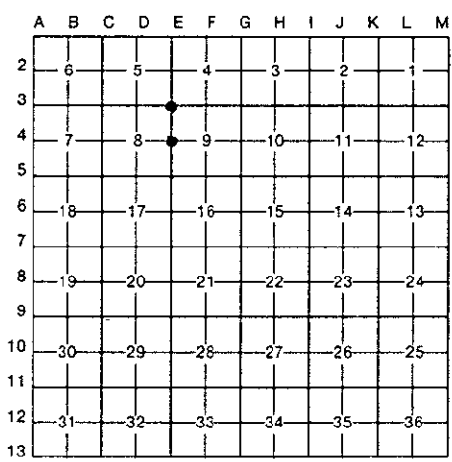

NOTE: Not more than 4 corners, all in the same town and range, may be recorded on this certificate.

- A. Description of original monument and accessories and/or subsequent restoration:
E-3 [NW COR SEC. 9] A.MERRYWETHER, DS-1848-SET WOOD POST (BIRCH 12" S41°E 40 LINKS)(WHITE MAPLE 10" N20°W 10 LINKS) NO RECORD EVIDENCE OF CORNER RECOVERY AND/OR SUBSEQUENT MONUMENTATION
E-4 [W1/4 COR SEC 9] A.MERRYWEATHER, DS-1848-SET WOOD POST-(SUGAR 12" N46°E 08 LINKS)(SUGAR 08" S42°W 03 LINKS) NO RECORD EVIDENCE OF CORNER RECOVERY AND/OR SUBSEQUENT CORNER MONUMENTATION

- B. Description of corner evidence found and/or method applied in restoring or reestablishing corner:
E-3 [NW COR SEC. 9] FOUND IN PLACE AND IN POOR CONDITION A 1/2" X 12" IRON PIN SET BY PERSONS UNKNOWN. ID CORNER POSITION FROM E-W COUNTY ROAD IMPROVEMENTS AND APPARENT LONG STANDING FARM OCCUPATION LINES. ACCEPTED EXISTING MONUMENT AS BEING THE BEST AVAILABLE EVIDENCE AS TO THE LOCATION OF THE POSITION OF THE ORIGINAL CORNER.
E-4 [W1/4 COR SEC 9] FOUND IN PLACE AT THE JCT OF FARM FENCES E-W & N AND APPROX C/L OF A SEASONAL COUNTY ROAD TO THE SOUTH, A 1" IRON PIPE SET BY PERSONS UNKNOWN. AS NO OTHER EVIDENCE EXIST AND IT IS APPARENT THAT THIS MONUMENT HAS BEEN HONORED FOR NUMEROUS YEARS I HAVE ACCEPTED THE EXISTING MONUMENT AT BEING THE BEST AVAILABLE EVIDENCE AS TO THE LOCATION OF THE POSITION OF THE ORIGINAL CORNER.

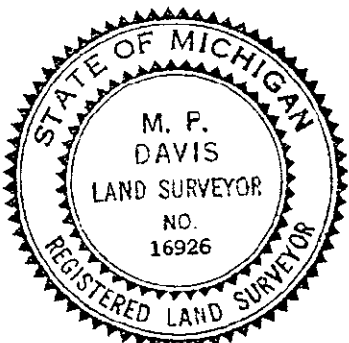

- C. Description of monument for corner and accessories established to perpetuate locating the position of the corner:
E-3 REPLACED EXISTING MONUMENT W/A 5/8" X 18" REBAR W/A 3 1/4" ALUM CAP STAMPED TO ID THE CORNER POSITION.
5/8" X 18" REBAR W/A 2" ALUM WIT CAP POWER POLE SURVEY MONUMENT SIGN POST
N45°E S45°E N18°W SOUTH
23.18' 30.16' 31.15' 22.90' (TO FACE)
E-4 SET, OVER EXISTING MONUMENT A BERNPSEN AINB30 ALUMN MON. W/A 3 1/4" CAP STAMPED TO ID THE CORNER POSITION.
APPLE 05" APPLE 04" W.CHERRY 05" SURVEY MONUMENT SIGN POST
WEST S36°E S29°W NORTE
20.91' 44.20' 54.36' 1.00' (TO FACE)

NOTE: BEARINGS TO REFERENCE OBJECTS ARE MAGNETIC-DISTANCES ARE TO A NAIL W/A DELTA COUNTY REFERENCE TAG, UNLESS OTHERWISE NOTED.

Signed by M.P. Davis Date 2/15/99
Surveyor's Michigan License No. 16926