JAN 2 5 2003

SECTION

Approved By Delta County
Land Survey Remonumentation
Peer Group Under Act 345 Of
P.A. Of 1990 On 2-3, 1999
David B. Babbitt
Chairman

LAND CORNER RECORDATION CERTIFICATE

Filing Requirement of Act 74, Mich. P.A. 1970

For corners in DELTA (County)

	Located In:	Corner Code #
1. Public Land Survey	T 39 N R 18 W	G - 2
	T 39 N R 18 W	G - 3 ✓
	T ___ R ___	
	T ___ R ___	
2. Property Controlling	S ___ T ___ R ___	
in Section	S ___ T ___ R ___	
3. Miscellaneous	S ___ T ___ R ___	
Property in Sec.	S ___ T ___ R ___	

Mar 4 1999
9:00 AM
9 Page 151
Register of Deeds Stamp & File Number

4. Lot No. _____, Recorded Plat _____
5. Private Claims _____

G-2 [W1/4 COR SEC 3] G-3 [NW COR SEC 10]

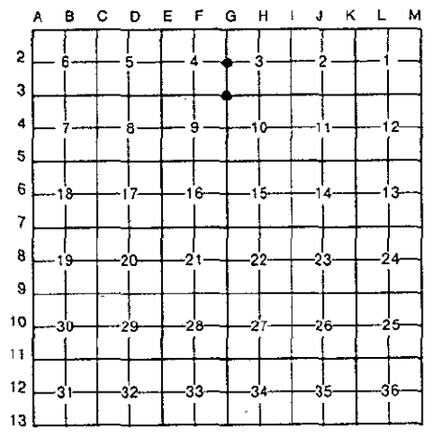

I, M.P. DAVIS, in a field survey on FEBRUARY, 19 99, do hereby certify that under requirements of P.A. 74, Michigan P.A. of 1970, the corner points mentioned in lines 1 and 2 above were in conformance with regulations and rules therefore as required in the current manual of survey instructions of the United States Department of the Interior, Bureau of Land Management or by a decree of a Court of Law and/or that the corner points mentioned in lines 3, 4 and 5 above were in conformance with the rules of the Michigan Board of Land Surveyors or by a Decree of a Court of Law; established, re-established, monumented, re-monumented, recovered, found as expressed below:

NOTE: Not more than 4 corners, all in the same town and range, may be recorded on this certificate.

A. Description of original monument and accessories and/or subsequent restoration:

G-2 [W1/4 COR SEC. 3] A.MERRYWEATHER,DS-1848-SET WOOD POST (SPRUCE 04" N60°E 05 LINKS)(BALSAM 04" S60°W 06 LINKS)
NO RECORD EVIDENCE OF CORNER RECOVERY AND/OR SUBSEQUENT MONUMENTATION

G-3 [NW COR SEC 10] A.MERRYWEATHER,DS-1848-SET WOOD POST-(BEECH 09" N18°E 17 LINKS)(BEECH 08" S52°W 40 LINKS)
FRANK BRAY, RLS-1972-L.1 PG.222 LCR'S-SET 1" I.P. AT JCT OF C.R. C/L'S WEST & SOUTH & FENCE LINE NORTH (ELM 24" N2°W 35.2')(E.GATE POST N50°E 40.8')

B. Description of corner evidence found and/or method applied in restoring or reestablishing corner:

G-2 [W1/4 COR SEC. 3] FOUND IN PLACE A 3/4" IRON PIN AT THE JCT OF ANCIENT FENCE LINES (DOWN AND IN POOR REPAIR) E-W & N. ALSO FOUND 2 CEDAR BT'S, NOT OF RECORD, BY BOWMAN/O'BRIEN LAND SURVEYORS. NO OTHER EVIDENCE FOUND, ACCEPTED EXISTING MONUMENT AS BEING THE BEST AVAILABLE EVIDENCE AS TO THE LOCATION OF THE POSITION OF THE ORIGINAL CORNER.

G-3 [NW COR SEC 10] FOUND IN PLACE A 1" IRON PIPE. ID CORNER MONUMENT FROM BT'S REC'D IN L.1 OF LCR'S PG.222. ACCEPTED EXISTING MONUMENT AS BEING THE BEST AVAILABLE EVIDENCE AS TO THE LOCATION OF THE POSITION OF THE ORIGINAL CORNER.

STATE OF MICHIGAN
M. P. DAVIS
LAND SURVEYOR
NO. 16926
REGISTERED LAND SURVEYOR

C. Description of monument for corner and accessories established to perpetuate locating the position of the corner:

G-2 SET, OVER EXISTING MONUMENT, A BERNTSEN A1NB30 ALUM MONUMENT W/A 3 1/4" CAP STAMPED TO ID THE CORNER POSITION.

CEDAR 09"(OLD BT)	CEDAR 07"(OLD BT)	CEDAR 05"	YELLOW BIRCH 15"	SURVEY MONUMENT SIGN POST
N53°E	S15°E	N43°W	S39°W	SOUTH
15.60'	23.59'	24.38'	41.61'	1.04' (TO FACE)

G-3 SET, OVER EXISTING MONUMENT, A BERNTSEN A1NB30 ALUMN MON. W/A 3 1/4" CAP STAMPED TO ID THE CORNER POSITION.

W.PINE 10"	2 1/2" GALV RD SIGN POST	POWER POLE	2 1/2" STEEL NORTH GATE POST	SURVEY MONUMENT SIGN POST
S49°W	N58°W	S44°E	S88°E	SOUTH
82.16'	43.08' (TO FACE)	25.33'	74.28' (TO FACE)	8.18' (TO FACE)

NOTE: BEARINGS TO REFERENCE OBJECTS ARE MAGNETIC-DISTANCES ARE TO A NAIL W/A DELTA COUNTY REFERENCE TAG, UNLESS OTHERWISE NOTED.

Signed by M.P. Davis Date 2/22/99

Surveyor's Michigan License No. 16926

FORM APPROVED BY MICHIGAN STATE BOARD OF LAND SURVEYORS, JAN. 28, 1971
REVISED MAY 14, 1975
REVISED JAN., 1983