

JAN 20 2001

Approved By Delta County  
Land Survey Remonumentation,  
Peer Group Under Act 345 Of  
P.A. Of 1990 On 3-3, 1999  
David B. Bobbitt  
Chairman

SECTION

LAND CORNER RECORDATION CERTIFICATE  
Filing Requirement of Act 74, Mich. P.A. 1970

For corners in

<u>DELTA</u> (County)	Located In:	Corner Code #
1. Public Land Survey	T 39 N R 18 W T 39 N R 18 W T _____ R _____ T _____ R _____	H - 5 ✓ L - 5
2. Property Controlling in Section	S _____ T _____ R _____ S _____ T _____ R _____	
3. Miscellaneous Property in Sec.	S _____ T _____ R _____ S _____ T _____ R _____	

RECORDED Mar 4 1999  
at 9:00 AM  
Book 9 Page 154  
John C. Thomas  
CLERK OF COURT

Register of Deeds Stamp & File Number

- 4. Lot No. \_\_\_\_\_, Recorded Plat \_\_\_\_\_
- 5. Private Claims \_\_\_\_\_

H-5 [N1/4 COR SEC 15] L-5 [N1/4 COR SEC 13]

I, M.P. DAVIS, in a field survey on FEBRUARY, 1999, do hereby certify that under requirements of P.A. 74, Michigan P.A. of 1970, the corner points mentioned in lines 1 and 2 above were in conformance with regulations and rules therefore as required in the current manual of survey instructions of the United States Department of the Interior, Bureau of Land Management or by a decree of a Court of Law and/or that the corner points mentioned in lines 3, 4 and 5 above were in conformance with the rules of the Michigan Board of Land Surveyors or by a Decree of a Court of Law; established, re-established, monumented, re-monumented, recovered, found as expressed below:

A	B	C	D	E	F	G	H	I	J	K	L	M
2	6	5	4	3	2	1						
3												
4	7	8	9	10	11	12						
5												
6	18	17	16	15	14	13						
7												
8	19	20	21	22	23	24						
9												
10	30	29	28	27	26	25						
11												
12	31	32	33	34	35	36						
13												

NOTE: Not more than 4 corners, all in the same town and range, may be recorded on this certificate.

A. Description of original monument and accessories and/or subsequent restoration:


H-5 [N1/4 COR SEC. 15] A.MERRYWEATHER, DS-1848-SET WOOD POST (CEDAR 07" N40°W 17 LINKS)(CEDAR 05" S40°E 34 LINKS) FRANK BRAY, RLS-1972-L.1 PG.224 LCR'S-SET 1/2" REBAR IN LINE WITH FENCES N & S & MIDWAY BETWEEN E-W R/W FENCES (FENCE COR N1°W 32.3')(FENCE CORNER S1°E 32.3')(PP S49°E 47.8')

L-5 [N1/4 COR SEC. 13] A.MERRYWEATHER, DS-1848-SET WOOD POST (BEECH 08" S15°W 19 LINKS)(BIRCH 07" N45°E 27 LINKS) M.S.McNABB-1931-FOUND IN PLACE IRON STAKE 33' WEST OF CORNER FENCE POST (MAPLE 09" S25°W 33.4') FRANK BRAY, RLS-1970-FOUND IN PLACE A 1" IRON ROD-ID CORNER MONUMENT FROM McNABB'S COR POST BT S88°E 33.0' (MAPLE 12" S35°W 41.5') MAPLE 10" S55°E 36.8')

B. Description of corner evidence found and/or method applied in restoring or reestablishing corner:

H-5 [N1/4 COR SEC. 15] FOUND IN PLACE A 1/2" X 12" REBAR. ID CORNER MONUMENT AS THAT SET BY FRANK BRAY, RLS FROM BT'S REC'D AT L.1 OF LCR'S PG.224. ACCEPTED EXISTING MONUMENT AS BEING THE BEST AVAILABLE EVIDENCE AS TO THE LOCATION OF THE POSITION OF THE ORIGINAL CORNER.

L-5 [N1/4 COR SEC 13] FOUND IN PLACE A 1" SOLID IRON PIN. ID CORNER MONUMENT FROM SE BT (STILL GREEN) AS NOTED BY FRANK BRAY, RLS AT L.1 OF LCR'S PG.224. ACCEPTED EXISTING MONUMENT AS BEING THE BEST AVAILABLE EVIDENCE AS TO THE LOCATION OF THE POSITION OF THE ORIGINAL CORNER.

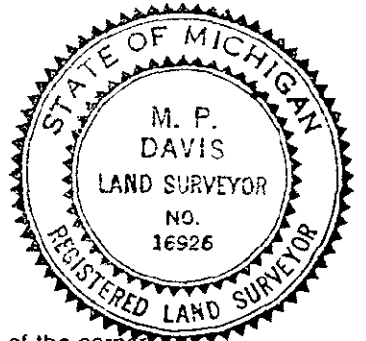

C. Description of monument for corner and accessories established to perpetuate locating the position of the corner.

H-5 REPLACED EXISTING MONUMENT W/A 5/8" X 18" REBAR W/A 3 1/4" ALUM CAP STAMPED TO ID THE CORNER POSITION.  
SPRUCE 05" CEDAR 11" POWER POLE 4" STEEL GATE POST SURVEY MONUMENT SIGN POST  
N53°E N46°W S39°E NORTH SOUTH  
53.25' 50.82' 48.38' 36.08' (TO FACE) 29.45' (TO FACE)

L-5 SET, OVER EXISTING MONUMENT, A BERNTSEN AINB30 ALUM MONUMENT W/A 3 1/4" CAP STAMPED TO ID THE CORNER POSITION.  
CEDAR 07" MAPLE 12" (OLD BT) GUY POLE GUY POLE SURVEY MONUMENT SIGN POST  
N59°W S55°E S61°W N55°E SOUTH  
96.40' 37.57' 36.22' 44.40' 11.95' (TO FACE)

NOTE: BEARINGS TO REFERENCE OBJECTS ARE MAGNETIC-DISTANCES ARE TO A NAIL W/A DELTA COUNTY REFERENCE TAG, UNLESS OTHERWISE NOTED.

Signed by M.P. Davis 3/1/99 Date \_\_\_\_\_

Surveyor's Michigan License No. 16926