

JAN 15 2000

SECTION

Approved By Delta County  
Land Survey Remonumentation  
Peer Group Under Act 345 Of  
P.A. Of 1990 On Dec 28, 1999

LAND CORNER RECORDATION CERTIFICATE  
Filing Requirement of Act 74, Mich. P.A. 1970

Robert A. Hummel  
Chairman

For corners in

DELTA (County)	Located In:	Corner Code #
1. Public Land Survey	T 39 N R 18 W	M-06 SAME ✓
	T 39 N R 17 W	A-06 CORNER
	T 39 N R 18 W	M-08 SAME
	T 39 N R 17 W	A-08 CORNER
	S _____ T _____ R _____	_____
2. Property Controlling in Section	S _____ T _____ R _____	_____
	S _____ T _____ R _____	_____
3. Miscellaneous Property in Sec.	S _____ T _____ R _____	_____
	S _____ T _____ R _____	_____

RECORDED 01-04-00  
AT 2:00 O'CLOCK PM  
LIBER 9 PAGE 186  
James C. ...  
COUNTY REG. CLERK

Register of Deeds Stamp & File Number

M-06 [E1/4 COR SEC 13] M-08 [E1/4 COR SEC 24]

4. Lot No. \_\_\_\_\_, Recorded Plat \_\_\_\_\_  
5. Private Claims \_\_\_\_\_

I, M.P. DAVIS, in a field survey on DECEMBER, 19 99 do hereby state that under requirements of P.A. 74, Michigan P.A. of 1970, the corner points mentioned in lines 1 and 2 above were in conformance with regulations and rules therefore as required in the current manual of survey instructions of the United States Department of the Interior, Bureau of Land Management or by a decree of a Court of Law and for that the corner points mentioned in lines 3, 4 and 5 above were in conformance with the rules of the Michigan Board of Land Surveyors or by a Decree of a Court of Law; established, re-established, monumented, recovered, found as expressed below:

NOTE: Not more than 2 corners, all in the same town and range, may be recorded on this certificate.

	A	B	C	D	E	F	G	H	I	J	K	L	M
1													
2	6	5	4	3	2	1							
3													
4	7	8	9	10	11	12							
5													
6	18	17	16	15	14	13							
7													
8	19	20	21	22	23	24							
9													
10	30	29	28	27	26	25							
11													
12	31	32	33	34	35	36							
13													

A. Description of original monument and accessories and/or subsequent restoration:


M-06 [E1/4 COR SEC 13] JOHN BURT, D.S.-1845-WOOD POST (CEDAR 14" N70°W 21 LINKS)(B.ASH 08" S45°W 10 LINKS)  
NO RECORD EVIDENCE OF CORNER RECOVERY AND/OR SUBSEQUENT MONUMENTATION.

M-08 [E1/4 COR SEC 24] JOHN BURT, D.S.-1845-INTERSECT LAKE - WOOD POST (W.BIRCH 04 N83°W 21 LINKS)(ASPEN 04" N82°E 22 LINKS)  
NO RECORD EVIDENCE OF CORNER RECOVERY AND/OR SUBSEQUENT MONUMENTATION.

B. Description of corner evidence found and/or method applied in restoring or reestablishing corner:

M-06 [E1/4 COR SEC 13] FOUND IN PLACE A 2-1/4" I.P. W/A 2-1/4" BRASS CAP STAMPED "CC 13 1/4 18"  
NO DATE SHOWN. ID CORNER MONUMENT AS BEING IN ITS' ORIGINAL POSITION FROM THE REMAINS OF THE "GLO" CEDAR BT RECORDED AS N70°W 21 LINKS MEASURES N70°E 21 LINKS. THE BT IS NOW A 3' HIGH STUMP WITH THE MEASURING NOTCH AND LOWER BLAZE IRON MARKS PLAIN, THE UPPER BLAZE IRON MARKS ARE BADLY FADED. ACCEPTED EXISTING MONUMENT AS BEING A CAREFUL & FAITHFULL PERPETUATION OF THE POSITION OF THE ORIGINAL CORNER.

M-08 [E1/4 COR SEC 24] NO CORNER EVIDENCE FOUND. REESTABLISHED THE CORNER POSITION BY EXTENDING THE LINE FROM THE E1/4 CORNER OF SEC 13 SOUTH THRU THE NE CORNER OF SEC 24 AND PLACING THE 1/4 CORNER ON THIS LINE AND AT RECORD DISTANCE (2640') SOUTH OF THE NE CORNER OF SEC 24. THIS POSITION NOW FALLS 90± INLAND FROM THE EDGE OF THE UPLAND VEGATATION LINE.

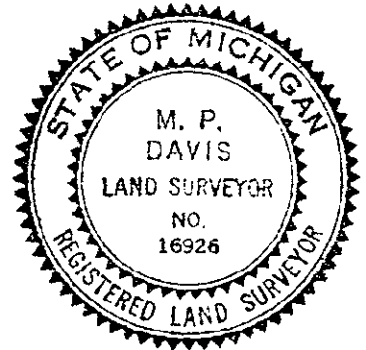

C. Description of monument for corner and accessories established to perpetuate locating the position of the corner:

M-06 DID NOT DISTURB THE EXISTING MONUMENT.

CEDAR 09"	CEDAR 11"	CEDAR 09"	CEDAR 12"	SURVEY MONUMENT SIGN POST
N43°W	N05°E	S85°E	S67°W	NORTH
29.60'	25.87'	13.12'	18.88'	2.63' (TO FACE)

M-08 SET A 5/8" X 18" REBAR W/A 3-1/4" ALUM CAP STAMPED TO ID THE CORNER POSITION.

W.BIRCH 08"	SPRUCE 07"	SPRUCE 07"	SPRUCE 07"	SURVEY MONUMENT SIGN POST
N24°W	N50°E	S22°E	S77°W	NORTH
17.64'	18.81'	18.91'	12.35'	1.30' (TO FACE)

NOTE: BEARINGS TO REFERENCE OBJECTS ARE MAGNETIC-DISTANCES ARE TO A NAIL W/A DELTA COUNTY REFERENCE TAG, UNLESS OTHERWISE NOTED.

Signed by M.P. Davis  
Surveyor's Michigan License No. 16926

Date 12/23/99