

RECORDED  
 JAN 2 2000  
 SECTION

Approved By Delta County  
 Land Survey Remonumentation  
 Peer Group Under Act 345 Of  
 P.A. Of 1990 On Dec 28, 1999  
*Chet Dehmelring*  
 County Chairman


LAND CORNER RECORDATION CERTIFICATE  
 Filing Requirement of Act 74, Mich. P.A. 1970

For corners in

DELTA (County)	Located In:	Corner Code #
1. Public Land Survey	T 39 NR 19 W T 39 NR 19 W T R T R	I-07 ✓ MC K-6/7 (2)
2. Property Controlling in Section	S T R S T R	
3. Miscellaneous Property in Sec.	S T R S T R	

4. Lot No. \_\_\_\_\_, Recorded Plat \_\_\_\_\_  
 5. Private Claims \_\_\_\_\_

01-04.00  
 2:00 o'clock PM  
 BOOK 9 PAGE 176  
 Register of Deeds Stamp & File Number

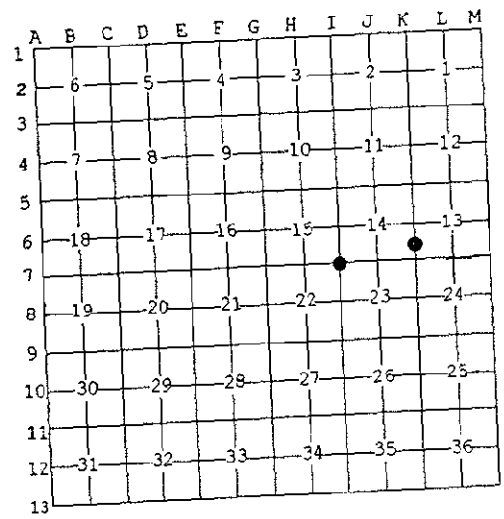

I-07 [NW COR SEC 23] K-6/7 [MC SEC 14/13]


I, M.P. DAVIS, in a field survey on DECEMBER, 19 99 do hereby state that under requirements of P.A. 74, Michigan P.A. of 1970, the corner points mentioned in lines 1 and 2 above were in conformance with regulations and rules therefore as required in the current manual of survey instructions of the United States Department of the Interior, Bureau of Land Management or by a decree of a Court of Law and/or that the corner points mentioned in lines 3, 4 and 5 above were in conformance with the rules of the Michigan Board of Land Surveyors or by a Decree of a Court of Law, established, re-established, monumented, recovered, found as expressed below:

NOTE: Not more than 2 corners, all in the same town and range, may be recorded on this certificate.

A. Description of original monument and accessories and/or subsequent restoration:

I-07 [NW COR SEC 23] A.MERRYWEATHER, D.S.-1848-WOOD POST (BALM A GILEAD 04" N80°E 21 LINKS)(POPLAR 04" S70°W 32 LINKS) Wm.BOWMAN PLS-1989-L.6 OF LCR'S PG.84A- REESTABLISHED CORNER POSITION FROM "GLO" FEATURE CALLS N-S & W. SET A1/2" IRON BAR W/A ID CAP (CEDAR 6" S34°W 14.0')(CEDAR 10" N72°W 25.5')(CEDAR 14" N55°E 14.7')

K-6/7 [MC SEC 14/13] A.MERRYWEATHER, D.S.-1848-WOOD POST (POPLAR 10" S20°W 88 LINKS) NO RECORD EVIDENCE OF CORNER RECOVERY AND/OR SUBSEQUENT MONUMENTATION.

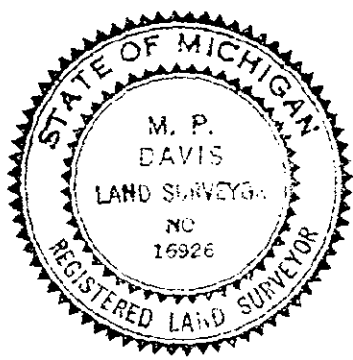

B. Description of corner evidence found and/or method applied in restoring or reestablishing corner:

I-07 [NW COR SEC 23] FOUND IN PLACE A 1/2" REBAR W/A ID CAP - ID CORNER MONUMENT FROM BOWMAN'S BT'S REC'D AT LIBER 6 OF LCR'S PG 84A ALL STILL VIABLE. ACCEPTED EXISTING MONUMENT AS BEING A CAREFULL & FAITHFULL REESTABLISHMENT OF THE POSITION OF THE ORIGINAL CORNER.

K-6/7 [MC SEC 14/13] FOUND IN PLACE A 1/2" IRON BAR WITH RLS CAP #21274 ATTACHED AND SET AT "GLO" DISTANCE NORTH OF THE SW CORNER OF SEC 13. MONUMENTED POSITION FALLS AT THE DIVIDING LINE BETWEEN THE UPLAND AND SUBMERGED VEGETATION. NO OTHER EVIDENCE FOUND. ACCEPTED EXISTING MONUMENT AS BEING A CAREFUL & FAITHFUL REESTABLISHMENT OF THE LOCATION OF THE POSITION OF THE ORIGINAL CORNER.

C. Description of monument for corner and accessories established to perpetuate locating the position of the corner:

I-07 REPLACED EXISTING MONUMENT, W/A 5/8" X 18" REBAR W/A 3-1/4" ALUM CAP STAMPED TO ID THE CORNER POSITION

CEDAR 11"(OLD BT)	CEDAR 15"(OLD BT)	CEDAR 04"	CEDAR 10"(OLD BT)
N72°W	N55°E	S48°E	S34°W
25.50'	14.70'	16.79'	14.00'

K-6/7 REPLACED EXISTING MONUMENT W/A BERNTSEN A1NB30 ALUM MONUMENT WITH THE CAP STAMPED TO ID THE CORNER POSITION.

CEDAR 09"	CEDAR 09"	CEDAR 12"	SURVEY MONUMENT SIGN POST
S75°W	S25°E	S20°W	N29°E
19.83'	35.29'	30.28'	1.04' (TO FACE)

NOTE: BEARINGS TO REFERENCE OBJECTS ARE MAGNETIC-DISTANCES ARE TO A NAIL W/A DELTA COUNTY REFERENCE TAG, UNLESS OTHERWISE NOTED.

Signed by M.P. Davis  
 Surveyor's Michigan License No. 16926

Date 12/28/99