

JAN 25 2000

Approved By Delta County  
Land Survey Remonumentation  
Peer Group Under Act 345 Of  
P.A. Of 1990 On Dec 28, 1999

LAND CORNER RECORDATION CERTIFICATE

Filing Requirement of Act 74, Mich. P.A. 1970

*Robert Schmalzer*  
Chairman

For corners in SECTION

DELTA (County)	Located In:	Corner Code #
1. Public Land Survey	T 39 N R 19 W	1-12 ✓
	T 39 N R 19 W	H-11
2. Property Controlling in Section	T R	
	T R	
	T R	
3. Miscellaneous Property in Sec.	S T R	
	S T R	

01-04-00  
2:00 O'CLOCK PM  
9 PAGE 172  
Register of Deeds Stamp & File Number

I-12 [W1/4 COR SEC 35] H-11 [N1/4 COR SEC 34]

4. Lot No. \_\_\_\_\_, Recorded Plat \_\_\_\_\_  
5. Private Claims \_\_\_\_\_

M.P. DAVIS, in a field survey on NOVEMBER, 19 99 do hereby state that under requirements of P.A. 74, Michigan P.A. of 1970, the corner points mentioned in lines 1 and 2 above were in conformance with regulations and rules therefore as required in the current manual of survey instructions of the United States Department of the Interior, Bureau of Land Management or by a decree of a Court of Law and /or that the corner points mentioned in lines 3, 4 and 5 above were in conformance with the rules of the Michigan Board of Land Surveyors or by a Decree of a Court of Law; established, re-established, monumented, recovered, found as expressed below:

A	B	C	D	E	F	G	H	I	J	K	L	M
1												
2	6		5		4		3		2			1
3												
4	7		8		9		10		11			12
5												
6	18		17		16		15		14			13
7												
8	19		20		21		22		23			24
9												
10	30		29		28		27		26			25
11							•					
12	31		32		33		•		35			36
13												


NOTE: Not more than 2 corners, all in the same town and range, may be recorded on this certificate.

A. Description of original monument and accessories and/or subsequent restoration:

- I-12 [W1/4 COR SEC 35] A.MERRYWEATHER, D.S.-1848-WOOD POST (BEECH 16" S34°W 32 LINKS)(BEECH 09" N35°E 20 LINKS) DAVE BABBITT M.D.N.R.-1978-L.2 PG.215 OF LCR'S-SET FROM EXISTING OCCUPATION LINES. STONE FENCE EAST AND CEDAR FENCE POST FENCE SOUTH. SET 1" I.P. W/A 4" ALUM CAP STAMPED TO ID THE CORNER POSITION FROM WHICH A RED PINE 5" N28°E 52.5' AND A RED PINE 4" N82°E 25.1 AND AN APPLE 6" S10°W 102.5'
- H-11 [N1/4 COR SEC 34] A.MERRYWEATHER, D.S.-1848-WOOD POST (BEECH 05" S70°W 14 LINKS)(SUGAR 24" N71°E 06 LINKS) DAVE BABBITT M.D.N.R.-1978-L.2 PG.213 OF LCR'S-FOUND, IN PLACE, A 3/4" I.P. - ID CORNER POSITION FROM EXISTING OCCUPATION (FENCE WEST )(C/L OF COUNTY ROAD N & S). SET OVER EXISTING MONUMENT A 1" IRON PIPE W/A 4" ALUM CAP STAMPED TO ID THE CORNER POSITION FROM WHICH A W.BIRCH 12" TWIN S20°E 84.6', A SCOTCH PINE 6" N26°E 53.3' AND AN APPLE 2" N88° 62.6'

B. Description of corner evidence found and/or method applied in restoring or reestablishing corner:

- I-12 [W1/4 COR SEC 35] FOUND IN PLACE A 1" IRON PIPE W/A 4" ALUM CAP ATTACHED AND STAMPED TO ID THE CORNER POSITION. ID EXISTING MONUMENT AS THAT HAVING BEEN SET BY DAVE BABBITT FROM HIS RED PINE BT'S AS LISTED ABOVE WHICH ARE STILL GREEN WITH FACE BLAZES GROWN SHUT. ACCEPTED EXISTING MONUMENT AS BEING THE BEST AVAILABLE EVIDENCE AS TO THE LOCATION OF THE POSITION OF THE ORIGINAL CORNER.
- H-11 [N1/4 COR SEC 34] FOUND IN PLACE AND SET IN APPROXIMATE C/L OF N-S COUNTY ROAD A 1" I.P W/A 4" ALUM CAP STAMPED TO ID THE CORNER POSITION. ALL ACCESSORIES NOTED BY DAVE BABBITT IN 1978 HAVE BEEN DESTROYED. ACCEPTED EXISTING MONUMENT, AS IT APPEARS TO BE UNDISTURBED FROM ITS' ORIGINAL POSITION, AS BEING THE BEST AVAILABLE EVIDENCE AS TO THE LOCATION OF THE POSITION OF THE ORIGINAL CORNER.

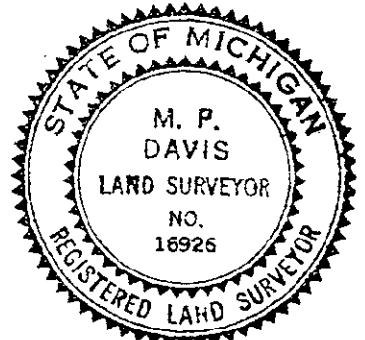

C. Description of monument for corner and accessories established to perpetuate locating the position of the corner:

- I-12 DID NOT DISTURB EXISTING MONUMENT.  
RED PINE 13"(OLD BT) RED PINE 11"(OLD BT) SURVEY MONUMENT SIGN POST  
N36°E N82°E NORTH  
52.63' 25.20' 1.60'(TO FACE)
- H-11 DID NOT DISTURB EXISTING MONUMENT.  
5/8" X 18" REBAR W/A 2" ALUM WIT. CAP SURVEY MONUMENT SIGN POST NOTE: FARM FIELDS IN ALL  
N45°W S45°W NORTH 4 QUADRANTS.  
17.18' 20.88' 17.60'(TO FACE)

NOTE: BEARINGS TO REFERENCE OBJECTS ARE MAGNETIC-DISTANCES ARE TO A NAIL W/A DELTA COUNTY REFERENCE TAG, UNLESS OTHERWISE NOTED.

Signed by M.P. Davis  
Surveyor's Michigan License No. 16926

Date 12/20/99