

JAN 25 2000

SECTION

LAND CORNER RECORDATION CERTIFICATE
Filing Requirement of Act 74, Mich. P.A. 1970

Approved By Delta County
Land Survey Remonumentation
Peer Group Under Act 345 Of
P.A. Of 1990 On Dec 28, 1999

M. P. Davis
Chairman

For corners in

DELTA (County)	Located In:	Corner Code #
1. Public Land Survey	T 39 N R 19 W	H-13 SAME
	T 38 N R 19 W	H-01 CORNER
	T 39 N R 19 W	K-13 SAME ✓
	T 38 N R 19 W	K-01 CORNER
2. Property Controlling in Section	S ___ T ___ R ___	_____
	S ___ T ___ R ___	_____
	S ___ T ___ R ___	_____
3. Miscellaneous Property in Sec.	S ___ T ___ R ___	_____
	S ___ T ___ R ___	_____

01-04-00
2:00 P.M.
9 PAGE 192
Walker & Thum
Register of Deeds Stamp & File Number

H-13 [S1/4 COR SEC 34] K-13 [SW COR SEC 36]

4. Lot No. _____, Recorded Plat _____
5. Private Claims _____

I, M.P. DAVIS, in a field survey on NOVEMBER, 1999 do hereby state that under requirements of P.A. 74, Michigan P.A. of 1970, the corner points mentioned in lines 1 and 2 above were in conformance with regulations and rules therefore as required in the current manual of survey instructions of the United States Department of the Interior, Bureau of Land Management or by a decree of a Court of Law and /or that the corner points mentioned in lines 3, 4 and 5 above were in conformance with the rules of the Michigan Board of Land Surveyors or by a Decree of a Court of Law; established, re-established, monumented, recovered, found as expressed below:

NOTE: Not more than 2 corners, all in the same town and range, may be recorded on this certificate.


	A	B	C	D	E	F	G	H	I	J	K	L	M
1													
2	6	5	4	3	2	1							
3													
4	7	8	9	10	11	12							
5													
6	18	17	16	15	14	13							
7													
8	19	20	21	22	23	24							
9													
10	30	29	28	27	26	25							
11													
12	31	32	33	34	35	36							
13													

A. Description of original monument and accessories and/or subsequent restoration:

- H-13 [S1/4 COR SEC 34] JOHN BURT, D.S.-1845-WOOD POST (SUGAR 12" N51°E 11 LINKS)(BIRCH D4" N74°W 31 LINKS) BILLY D. BUCKLER, D.N.R.-1962-L.3 LCR'S PG.214-FOUND IN PLACE AND IN LINE WITH N-S FARM FENCES A 1" IRON BAR, NO WIT'S NOTED. DAVE BABBITT, D.N.R.-1978-L.2 LCR'S PG. 218-FOUND IN PLACE AND IN LINE WITH N-S FARM FENCES A 1" IRON BAR FROM WHICH (IRONWOOD 6" N40°E 32.2')(COR FENCE POST N2°W 30.3')(MAPLE 3" S35°W 60.9')(MAPLE 18" N23°E 27.9') GARY KOEPKE, M.D.O.T.-1987-L.5 LCR'S PG.305-FOUND 1" IRON BAR VERIFIED FROM PREVIOUS WITNESSES AND NOTED (IRONWOOD 8' N45°E 32.58')(MAPLE 5' S40°W 61.28')(MAPLE 25" N20°E 28.31')(CHERRY 6" N85°E 65.25')
- K-13 [SW COR SEC 36] JOHN BURT, D.S.-1845-WOOD POST (MAPLE 09" N41°E 26 LINKS)(W.PINE 16" N63°W 45 LINKS) A.MERRYWEATHER, D.S.-1848-CORNER IN PLACE (SUGAR 09" S35°E 19 LINKS)(W.PINE 12" S61°W 28 LINKS) N.TROMBLEY (FOR M.S.McNABB)-1916-ESTABLISHED CORNERS FROM MEASUREMENTS N-S AND E FROM WHICH (W.BIRCH 4"S86°W 24.6")(PINE STUMP 20" N76°E 41') M.S.McNABB-1946-ID FROM PREVIOUS SURVEY-SET IRON IN ROAD FROM WHICH (W.PINE 8' N80°E 90.7')(MAPLE 10" S85°W 44.3') BILLY D. BUCKLER, D.N.R.-1961-L.3 OF LCR'S PG.209-SET 1/2" IRON BAR FROM PROBABLE BT FROM WHICH (J.PINE 5" N42°W 67 LINKS)(PP S83°E 82 LINKS)

B. Description of corner evidence found and/or method applied in restoring or reestablishing corner:

- H-13 [S1/4 COR SEC 34] FOUND IN PLACE 1" IRON BAR-ID CORNER MONUMENT FROM EXISTING WITNESSES AS LISTED ABOVE. ACCEPTED EXISTING MONUMENT AS BEING THE BEST AVAILABLE EVIDENCE AS TO THE LOCATION OF THE POSITION OF THE ORIGINAL CORNER.
- K-13 [SW COR SEC 36] FOUND IN PLACE A 5/8" X 15" IRON PIN. ID THIS MONUMENT AS BEING THE SAME AS SET BY McNABB IN 1946 FROM HIS W.PINE BT NE WHICH IS STILL GREEN WITH IRON MARKS PLAIN. UNABLE TO FIND THE BUCKLER MONUMENT, HOWEVER HIS J.PINE BT (NOW DEAD) IS STILL IN PLACE. BEARING AND DISTANCE FROM THE BT PLACES THE BUCKLER CORNER 21' WEST AND 12' SOUTH OF THE McNABB CORNER. ACCEPTED THE McNABB CORNER AS BEING THE BEST AVAILABLE EVIDENCE AS TO THE POSITION OF THE ORIGINAL CORNER.

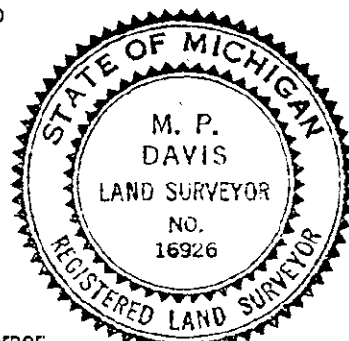

C. Description of monument for corner and accessories established to perpetuate locating the position of the corner:

- H-13 SET, OVER EXISTING MONUMENT, A 5/8" X 18" REBAR W/A 3-1/4" ALUM CAP STAMPED TO ID THE CORNER POSITION.

DRILL HOLES IN LARGE FIELD STONES	SURVEY MONUMENT SIGN POST
N03°W 24.46'	N50°E 28.97'
SOUTH 34.45'	N06°E 11.70'
- K-13 SET, OVER EXISTING MONUMENT, A 5/8" X 18" REBAR W/A 3-1/4" ALUM CAP STAMPED TO ID THE CORNER POSITION.

CEDAR 05"	RED PINE 12"	W.PINE 12" (OLD BT)	W.PINE 12"	SURVEY MONUMENT SIGN POST	C/L OF COUNTY ROAD WEST
N60°W 58.84'	N37°E 88.17'	N85°E 90.95'	S32°W 112.70'	N85°W 31.67'	SOUTH 55'±

NOTE: BEARINGS TO REFERENCE OBJECTS ARE MAGNETIC-DISTANCES ARE TO A NAIL W/A DELTA COUNTY REFERECNE TAG, UNLESS OTHERWISE NOTED.

Signed by M.P. Davis
Surveyor's Michigan License No. 16926

Date 12/20/99