

JAN 25 2000

Approved By Delta County
Land Survey Remonumentation
Peer Group Under Act 345 Of
P.A. Of 1990 On Dec 28, 1999

LAND CORNER RECORDATION CERTIFICATE
Filing Requirement of Act 74, Mich. P.A. 1970

M.P. Davis
Chairman

SECTION

For corners in

DELTA (County)	Located In:	Corner Code #
1. Public Land Survey	T 39 N R 19 W	L-09
	T 39 N R 19 W	L-11 ✓
	T R	
	T R	
	T R	
2. Property Controlling in Section	S T R	
	S T R	
3. Miscellaneous Property in Sec.	S T R	
	S T R	

01-04-00
2:00 O'CLOCK PM
L-09 9 PAGE 171
M.P. Davis

Register of Deeds Stamp & File Number

L-09 [N1/4 COR SEC 25] L-11 [N1/4 COR SEC 36]

4. Lot No. _____, Recorded Plat _____
5. Private Claims _____

I, M.P. DAVIS, in a field survey on NOVEMBER, 1999 do hereby state that under requirements of P.A. 74, Michigan P.A. of 1970, the corner points mentioned in lines 1 and 2 above were in conformance with regulations and rules therefore as required in the current manual of survey instructions of the United States Department of the Interior, Bureau of Land Management or by a decree of a Court of Law and /or that the corner points mentioned in lines 3, 4 and 5 above were in conformance with the rules of the Michigan Board of Land Surveyors or by a Decree of a Court of Law; established, re-established, monumented, recovered, found as expressed below:

NOTE: Not more than 2 corners, all in the same town and range, may be recorded on this certificate.


	A	B	C	D	E	F	G	H	I	J	K	L	M
1													
2	6		5		4		3		2		1		
3													
4	7		8		9		10		11		12		
5													
6	10		17		16		15		14		13		
7													
8	19		20		21		22		23		24		
9													
10	30		29		28		27		26		25		
11													
12	31		32		33		34		35		36		
13													

A. Description of original monument and accessories and/or subsequent restoration:

- L-09 [N1/4 COR SEC 25] A.MERRYWEATHER,D.S.-1848-WOOD POST (B.ASH 10" N40°W 09 LINKS)(B.ASH 12" S50°E 22 LINKS) NO RECORD EVIDENCE OF CORNER RECOVERY AND/OR SUBSEQUENT MONUMENTATION
- L-11 [N1/4 COR SEC 36] A.MERRYWEATHER,D.S.-1848-WOOD POST (HEMLOCK 25" N35°E 15 LINKS)(SUGAR 16" S41°W 15 LINKS) M.S.McNABB-1946-SET IRON AT FENCE LINES WEST & SOUTH (W.PINE 22" N60°E 73.5')

B. Description of corner evidence found and/or method applied in restoring or reestablishing corner:

- L-09 [N1/4 COR SEC 25] NO CORNER EVIDENCE FOUND. REESTABLISHED CORNER POSITION AT MIDPOINT AND ON LINE WITH SECTION CORNERS 1/2 MILE EAST AND WEST. CORNER POSITION FALLS ON NORTH SIDE OF EAST WEST FARM DITCH AND IN APPROXIMATE LINE WITH ANCIENT EAST WEST FARM FENCE DOWN AND AND IN POOR REPAIR.
- L-11 [N1/4 COR SEC 36] FOUND IN PLACE AND SET AT JUNCTION OF FARM FENCES WEST AND SOUTH AND IRON BOLT. IDENTIFIED EXISTING MONUMENT AS THAT SET IN 1946 BY M.S.McNABB FROM HIS W.PINE BT NE WHICH IS STILL GREEN WITH THE IRON MARKS STILL PLAIN. ACCEPTED EXISTING MONUMENT AS BEING THE BEST AVAILABLE EVIDENCE AS TO THE LOCATION OF THE POSITION OF THE ORIGINAL CORNER.

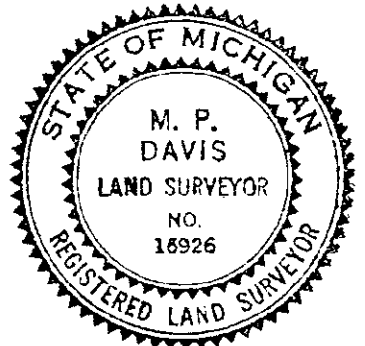

C. Description of monument for corner and accessories established to perpetuate locating the position of the corner:

- L-09 SET A BERNTSEN A1NB30 ALUM MONUMENT WITH THE CAP STAMPED TO ID THE CORNER POSITION.
ASH 4" ASH 14" C/L EAST END 36" CMP SURVEY MONUMENT SIGN POST
N31°W N38°E S62°W. NORTH
16.38' 41.52' 17.42' 2.10'(TO FACE)
- L-11 SET, OVER EXISTING MONUMENT, A BERNTSEN A1NB30 ALUM MONUMENT WITH THE CAP STAMPED TO ID THE CORNER POSITION.
W.PINE 12" BALSAM 08" W.PINE 48"(OLD BT) SURVEY MONUMENT SIGN POST
N40°W N02°W N64°E NORTH
89.65' 73.22' 74.32' 1.18'(TO FACE)

NOTE: BEARINGS TO REFERENCE OBJECTS ARE MAGNETIC-DISTANCES ARE TO A NAIL W/A DELTA COUNTY REFERENCE TAG, UNLESS OTHERWISE NOTED.

Signed by M.P. Davis Date 12/20/99
Surveyor's Michigan License No. 18926