

SURVEY & REMONUMENTATION

DEC 07 1993

COMMISSION

Approved By Delta County
Land Survey Remonumentation
Peer Group Under Act 345 Of
P.A. Of 1990 On November 30 1993
Ch. Belmeling
Acting Chairman

LAND CORNER RECORDATION CERTIFICATE
Filing Requirement of Act 74, Mich. P.A. 1970

For corners in

DELTA

(County)

Located In:

Corner Code #

1. Public Land Survey	T <u>39 N</u> R <u>23 W</u>	<u>A-7 & K-13</u>
	T _____ R _____	_____
	T _____ R _____	_____
	T _____ R _____	_____
2. Property Controlling in Section	S _____ T _____ R _____	_____
	S _____ T _____ R _____	_____
3. Miscellaneous Property in Sec.	S _____ T _____ R _____	_____
	S _____ T _____ R _____	_____

DELTA COUNTY

LIBER 7 PAGE 332

93 DEC -2 AM 9:00

Wallace A. Hanson
REGISTER OF DEEDS

Register of Deeds Stamp & File Number

4. Lot No. _____, Recorded Plat _____
5. Private Claims _____
A-7 [NW COR SEC 19] K-13 [SW COR SEC 36]


A	B	C	D	E	F	G	H	I	J	K	L	M
2	6	5	4	3	2	1						
3												
4	7	8	9	10	11	12						
5												
6	18	17	16	15	14	13						
7												
8	19	20	21	22	23	24						
9												
10	30	29	28	27	26	25						
11												
12	31	32	33	34	35	36						
13												

I, M.P. DAVIS, in a field survey on MAY, 19 93, do hereby certify that under requirements of P.A. 74, Michigan P.A. of 1970, the corner points mentioned in lines 1 and 2 above were in conformance with regulations and rules therefore as required in the current manual of survey instructions of the United States Department of the Interior, Bureau of Land Management or by a decree of a Court of Law and/or that the corner points mentioned in lines 3, 4 and 5 above were in conformance with the rules of the Michigan Board of Land Surveyors or by a Decree of a Court of Law; established, re-established, monumented, re-monumented, recovered, found as expressed below:

NOTE: Not more than 4 corners, all in the same town and range, may be recorded on this certificate.

- A. Description of original monument and accessories and/or subsequent restoration:
A-7 [NW COR SEC 19] WOOD POST - JOHN BURT - 1845 - (BEECH 8"-S15°W-31 LINKS) (Y. BIRCH 24"-N62°W-23 LINKS)
M.S. McNABB-1914-FOUND WOOD POST IN PLACE, RESET 5' IRON PIPE (HEMLOCK STUMP 12"-N62°E-51.2') (HEMLOCK STUMP 9"-S31°E-86.6')
K-13 [SW COR SEC 36] WOOD POST-WM. BURT-1844 (CEDAR 10"-N38°E-6 LINKS) (CEDAR 8"-S45°W-12 LINKS)
M.S. McNABB-1936-FOUND CONC. MON IN PLACE, ID FROM ESCANABA CITY ENGINEERS RECORDS - NOT WIT'S NOTED

- B. Description of corner evidence found and/or method applied in restoring or reestablishing corner:
A-7 [NW COR SEC 19] FOUND I.P. IN PLACE, 22" BELOW COUNTY ROAD SURFACE, AS INDICATED BY ROAD IMPROVEMENTS & OCCUPATION NO EVIDENCE OF McNAEB'S HEMLOCK BT'S FOUND
ACCEPTED EXISTING MON AS BEING A CAREFUL & FAITHFUL REESTABLISHMENT OF THE POSITION OF THE ORIGINAL CORNER
K-13 [SW COR SEC 36] FOUND 8" CONC MON W/A 3/4" BRASS PIN CENTER BY RETRACEMENT OF THE S. LINE OF SEC 36 AS PER CITY ENGINEERS RECORDS
ACCEPTED EXISTING MON AS BEING A CAREFUL & FAITHFUL REESTABLISHMENT OF THE POSITION OF THE ORIGINAL CORNER

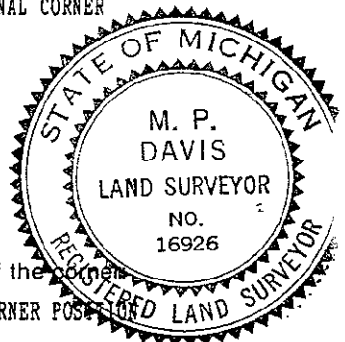

- C. Description of monument for corner and accessories established to perpetuate locating the position of the corner:
A-7 RAISED TO ROAD SURFACE W/A MONUMENT BOX AND A 5/8" X 18" REBAR W/A ALUMN CAP. STAMPED TO ID THE CORNER POST
POWER POLE TAMERACK SURVEY MONUMENT SIGN POST
N52°W S61°W EAST
32.20' 132.75' 33.0' (TO FACE)
K-13 DID NOT DISTURB EXISTING MONUMENT
W. BIRCH 7" COR FENCE POST SURVEY MONUMENT SIGN POST
N7°W S39°E N45°E
25.77' 13.88' (TO FACE) 1.60' (TO FACE)

NOTE: BEARINGS TO REFERENCE OBJECTS ARE MAGNETIC & DISTANCE ARE TO A NAIL IN THE CENTER OF THE OBJECT UNLESS NOTED OTHERWISE

Signed by M.P. Davis Date 11/15/93
Surveyor's Michigan License No. 16926