

SURVEY & REMONUMENTATION

DEC 07 1993

COMMISSION

Approved By Delta County
Land Survey Remonumentation
Peer Group Under Act 345 Of
P.A. Of 1990 On November 30, 1993
Richard Blumeling
Chairman

LAND CORNER RECORDATION CERTIFICATE Filing Requirement of Act 74, Mich. P.A. 1970

For corners in
DELTA
(County)

Located In: _____ Corner Code ##

DELTA COUNTY

LIBER 7 PAGE 338

93 DEC -2 AM 9:00

Walter C. Brown
REGISTER OF DEEDS

Register of Deeds Stamp & File Number

- | | | | |
|------------------------------------|-----------------------------|----------------|-------|
| 1. Public Land Survey | T <u>39 N</u> R <u>23 W</u> | A-3 <u>B-3</u> | |
| | T _____ R _____ | _____ | _____ |
| | T _____ R _____ | _____ | _____ |
| | T _____ R _____ | _____ | _____ |
| 2. Property Controlling in Section | S _____ T _____ R _____ | _____ | _____ |
| | S _____ T _____ R _____ | _____ | _____ |
| 3. Miscellaneous Property in Sec. | S _____ T _____ R _____ | _____ | _____ |
| | S _____ T _____ R _____ | _____ | _____ |

4. Lot No. _____, Recorded Plat _____
5. Private Claims _____
A-3 [NW COR SEC 7] B-3 [1/4 COR COMMON TO SEC'S 6/7]


I, M.P. DAVIS, in a field survey on MAY, 19 93, do hereby certify that under requirements of P.A. 74, Michigan P.A. of 1970, the corner points mentioned in lines 1 and 2 above were in conformance with regulations and rules therefore as required in the current manual of survey instructions of the United States Department of the Interior, Bureau of Land Management or by a decree of a Court of Law and/or that the corner points mentioned in lines 3, 4 and 5 above were in conformance with the rules of the Michigan Board of Land Surveyors or by a Decree of a Court of Law; established, re-established, monumented, re-monumented, recovered, found as expressed below:

NOTE: Not more than 4 corners, all in the same town and range, may be recorded on this certificate.

	A	B	C	D	E	F	G	H	I	J	K	L	M
2	6	5	4	3	2	1							
3	7	8	9	10	11	12							
4													
5													
6	18	17	16	15	14	13							
7													
8	19	20	21	22	23	24							
9													
10	30	29	28	27	26	25							
11													
12	31	32	33	34	35	36							
13													

- A. Description of original monument and accessories and/or subsequent restoration:
- A-3 [NW COR SEC 7] WOOD POST - JOHN BURT - 1845 (HEMLOCK 16'-S40°W-16 LINKS) (Y.BIRCH 5'-N67°W-14 LINKS)
D.A. BROTHERTON - 1908 - STAKE IN PLACE - IN NORTH TRACK OF WAGON ROAD OPPOSITE FENCE TO NORTH
M.S. McNABB - 1921 - FOUND STAKE 1' UNDER SURFACE OF ROAD DROVE IRON - COR FENCE POST - NORTH 23.5'
- B-3 [1/4 COR COMMON TO SEC'S 6/7] WOOD POST - A. HERRYWEATHER - 1846 (TAMERAC 12'-S72°E-7 LINKS) (TAMERAC 12'-S80°W-15 LINKS)
M.S. McNABB - 1920 & 21 - FOUND STAKE IN MACADAM ROAD - COR FENCE POST S37°W-32.0' -- TAM 3'-N45°E-40.5'

- B. Description of corner evidence found and/or method applied in restoring or reestablishing corner:
- A-3 [NW COR SEC 7] FOUND McNABB'S IRON STAKE AS INDICATED BY COUNTY ROAD IMPROVEMENTS & REMAINS OF OLD FENCE TO THE NORTH ACCEPTED EXISTING MONUMENT AS BEING A CAREFUL & FAITHFUL REESTABLISHMENT OF THE POSITION OF THE ORIGINAL CORNER
- B-3 [1/4 COR COMMON TO SEC'S 6/7] FOUND McNABB'S 1921 W1/16 ON LINE BETW SEC'S 6 & 7 -- EXTENDED LINE EAST FROM NW COR SEC 7 THRU FOUND W1/16 AND SET 1/4 COR ON THIS LINE AND PROPORTIONATE DISTANCE EAST OF THE W1/16. FROM WHICH A SCRIBED FENCE POST WAS FOUND TO BEAR S37°W-32.0'
ACCEPTED THIS POSITION AS BEING A CAREFUL & FAITHFUL REESTABLISHMENT OF THE POSITION OF THE ORIGINAL CORNER

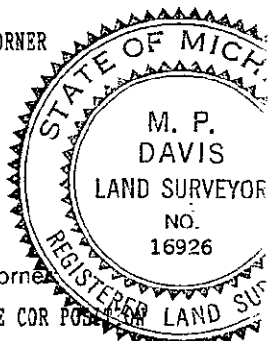

- C. Description of monument for corner and accessories established to perpetuate locating the position of the corner:
- A-3 [NW COR SEC 7] SET, OVER EXISTING MONUMENT, A BERNTSEN ALUMN MON W/A 3-1/4" CAP STAMPED TO ID THE COR POSITION
- | | | | | |
|------------|------------|------------------|----------|---------------------------|
| SPRUCE 13" | POWER POLE | POWER POLE | TAMERACK | SURVEY MONUMENT SIGN POST |
| N56°W | N65°E | S54°E | S40°W | NORTH |
| 48.08' | 60.53' | 70.88' (TO FACE) | 107.60' | 8.82' (TO FACE) |
- B-3 [1/4 COR COMMON TO SEC'S 6/7] SET 5/8" X 18" REBAR W/A ALUMN CAP STAMPED TO ID THE COR POSITION & RAISED TO RD SURFACE W/A MON E
- | | | | |
|----------|----------|----------|---------------------------|
| CEDAR 6" | CEDAR 6" | CEDAR 7" | SURVEY MONUMENT SIGN POST |
| N29°W | N24°W | S57°W | S46°E |
| 66.62' | 64.62' | 53.28' | 31.92' (TO FACE) |

NOTE: BEARINGS TO REFERENCE OBJECTS ARE MAGNETIC & DISTANCES ARE TO A NAIL IN THE CENTER OF THE OBJECT UNLESS NOTED OTHERWISE

Signed by M.P. Davis Date 11/15/93
Surveyor's Michigan License No. 16926