

7-393

Approved By Delta County
Land Survey Remonumentation
Peer Group Under Act 345 Of
P.A. Of 1990 On May 12, 1994

LAND CORNER RECORDATION CERTIFICATE
Filing Requirement of Act 74, Mich. P.A. 1970

John Blumel
Chairman

For corners in
DELTA
(County)

Located In: Corner Code ##

- 1. Public Land Survey T 39 N R 23 W D-7 & E-6
- T _____ R _____
- T _____ R _____
- T _____ R _____
- 2. Property Controlling S _____ T _____ R _____
- in Section S _____ T _____ R _____
- 3. Miscellaneous S _____ T _____ R _____
- Property in Sec. S _____ T _____ R _____

MAY 13 1994

Recorded
9:00 AM in Liber 7 Page 393
at _____ o'clock
William C. Thomas
Reg. of Deeds.
Delta County, Michigan
Register of Deeds Stamp & File Number

- 4. Lot No. _____, Recorded Plat _____
- 5. Private Claims
D-7 [N1/4 COR SEC 20] E-6 [W1/4 COR SEC 16]


	A	B	C	D	E	F	G	H	I	J	K	L	N
2	6		5		4		3		2		1		
3													
4	7		8		9		10		11		12		
5													
6	18		17		16		15		14		13		
7													
8	19		20		21		22		23		24		
9													
10	30		29		28		27		26		25		
11													
12	31		32		33		34		35		36		
13													

I, M.P. DAVIS, in a field survey on APRIL, 19 94, do hereby certify that under requirements of P.A. 74, Michigan P.A. of 1970, the corner points mentioned in lines 1 and 2 above were in conformance with regulations and rules therefore as required in the current manual of survey instructions of the United States Department of the Interior, Bureau of Land Management or by a decree of a Court of Law and/or that the corner points mentioned in lines 3, 4 and 5 above were in conformance with the rules of the Michigan Board of Land Surveyors or by a Decree of a Court of Law; established, re-established, monumented, re-monumented, recovered, found as expressed below:

NOTE: Not more than 4 corners, all in the same town and range, may be recorded on this certificate.

- A. Description of original monument and accessories and/or subsequent restoration:
D-7 [N1/4 COR SEC 20] WOOD POST-1846-A. MERRYWEATHER D.S. (TAMERAC 06°-SOUTH-03 LINKS) (CEDAR 06°-NORTH-18 LINKS)
NO RECORD EVIDENCE OF CORNER RECOVERY OR MONUMENTATION
E-6 [W1/4 COR SEC 16] WOOD POST-1846-A. MERRYWEATHER, D.S. (HEMLOCK 09°-S45°W-05 LINKS) (HEMLOCK 11°-N70°E-05 LINKS)
NO RECORD EVIDENCE OF CORNER RECOVERY OR SUBSEQUENT MONUMENTATION

- B. Description of corner evidence found and/or method applied in restoring or reestablishing corner:
D-7 [N1/4 COR SEC 20] NO EVIDENCE OF CORNER MONUMENT FOUND. ESTABLISHED NEW POSITION AT JCT. OF ANCIENT FENCE LINES WEST & SOUTH. THIS POSITION FITS WELL WITH GLO STREAM X-ING CALL TO THE EAST & MATCHES WELL WITH COUNTY ROAD ALIGNMENT TO THE WEST & IS 11.87' SOUTH OF A STRAIGHT LINE BETWEEN S3C CORNERS TO THE EAST & WEST. ACCEPTED AS THE BEST AVAILABLE EVIDENCE AS TO THE POSITION OF THE ORIGINAL CORNER.
E-6 [W1/4 COR SEC 16] NO CORNER EVIDENCE FOUND. ESTABLISHED CORNER POSITION AT MIDPOINT BETWEEN BETWEEN S3C CORNERS NORTH & SOUTH.

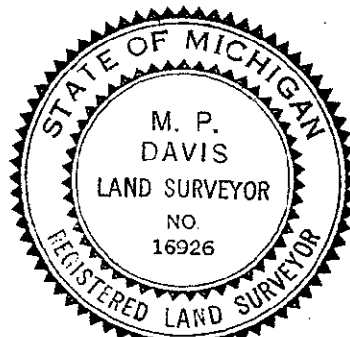

- C. Description of monument for corner and accessories established to perpetuate locating the position of the corner:
D-7 SET A BERNTSEN A1NB30 ALUNN MON WITH THE CAP STAMPED TO ID THE CORNER POSITION.
CEDAR 10" CEDAR 9" CEDAR 12" CEDAR 8" SURVEY MONUMENT SIGN POST
N75°W N17°E S89°E S30°E SOUTH
22.84' 9.75' 20.73 15.74' 1.94' (TO FACE)
E-6 SET BERNTSEN A1NB30 ALUNN MONUMENT WITH THE CAP STAMPED TO ID THE CORNER POSITION
MAPLE 09" MAPLE 08" MAPLE 12" CEDAR 07" SURVEY MONUMENT SIGN POST
S85°W N09°E S89°E S01°E S26°W
20.70' 8.62' 23.21' 22.00' 3.78' (TO FACE)

NOTE: BEARINGS TO REFERENCE OBJECTS ARE MAGNETIC & DISTANCES ARE TO A NAIL W/A REFERENCE TAG, UNLESS NOTED OTHERWISE

Signed by M.P. Davis Date 5/6/94
Surveyor's Michigan License No. 16926