

**SURVEY & REMONUMENTATION**

DEC 07 1993

COMMISSION

**LAND CORNER RECORDATION CERTIFICATE**  
**Filing Requirement of Act 74, Mich. P.A. 1970**

Approved By Delta County  
 Land Survey Remonumentation  
 Peer Group Under Act 345 Of  
 P.A. Of 1990 On October 21, 1993  
*Robert A. Schmalz*  
 Acting Chairman  
 DELTA COUNTY

For corners in  
 DELTA

(County)

Located In:

Corner Code ##

1. Public Land Survey	T <u>39 N</u> R <u>23 W</u>	<u>D-9</u> & <u>E-9</u>
	T _____ R _____	_____
	T _____ R _____	_____
	T _____ R _____	_____
2. Property Controlling in Section	S _____ T _____ R _____	_____
	S _____ T _____ R _____	_____
3. Miscellaneous Property in Sec.	S _____ T _____ R _____	_____
	S _____ T _____ R _____	_____

LIBER 7 PAGE 313

93 DEC -2 AM 9:00

*William C. Thoren*  
 REGISTER OF DEEDS

Register of Deeds Stamp & File Number

4. Lot No. \_\_\_\_\_, Recorded Plat \_\_\_\_\_  
 5. Private Claims \_\_\_\_\_  
1/4 CORNER COMMON TO SEC'S 20/29 AND NW CORNER OF SEC 28

A	B	C	D	E	F	G	H	I	J	K	L	M
2	6	5	4	3	2	1						
3												
4	7	8	9	10	11	12						
5												
6	18	17	16	15	14	13						
7												
8	19	20	21	22	23	24						
9												
10	30	29	28	27	26	25						
11												
12	31	32	33	34	35	36						
13												

I, M.P. DAVIS, in a field survey on AUGUST, 19 93, do hereby certify that under requirements of P.A. 74, Michigan P.A. of 1970, the corner points mentioned in lines 1 and 2 above were in conformance with regulations and rules therefore as required in the current manual of survey instructions of the United States Department of the Interior, Bureau of Land Management or by a decree of a Court of Law and/or that the corner points mentioned in lines 3, 4 and 5 above were in conformance with the rules of the Michigan Board of Land Surveyors or by a Decree of a Court of Law; established, re-established, monumented, re-monumented, recovered, found as expressed below:


**NOTE: Not more than 4 corners, all in the same town and range, may be recorded on this certificate.**

**A. Description of original monument and accessories and/or subsequent restoration:**

- D-9 [1/4 CORNER COMMON TO SEC'S 20/29] A. MERRYWEATHER - 1846 - WOOD POST - HEMLOCK 14" N72°E - 14 LINKS - HEMLOCK 10"-S33°W - 20 LINKS  
 M.S. McNABB - 1915 - IDENTIFIED WOOD STAKE IN PLACE DURING ROAD SURVEY FOR WELLS TOWNSHIP. SET BT STAKES NE-SW 33.0'
- E-9 [NW COR SEC 28] A. MERRYWEATHER - 1846 - WOOD POST - W. PINE 14" N74°W 27 LINKS - HEMLOCK 10" S40°E 12 LINKS  
 M.S. McNABB-1934-IDENTIFIED CORNER POSITION BY ORIGINAL BT (WHICH ONE NOT NOTED)  
 W.BIRCH 8"-S40°E -36' & W.PINE 7"-S55°W 44'

**B. Description of corner evidence found and/or method applied in restoring or reestablishing corner:**

- D-9 [1/4 CORNER COMMON TO SEC'S 20/29] IDENTIFIED CORNER POSITION FROM IRON STAKE AS DESCRIBED IN LIBER 1 OF L.C.R.'s. ON PAGE 46
- E-9 [NW CORNER SEC 28] IDENTIFIED CORNER POSITION FROM IRON PIPE W/A SURVEY CAP AS DESCRIBED IN LIBER 1 OF L.C.R.'s. ON PAGE 44

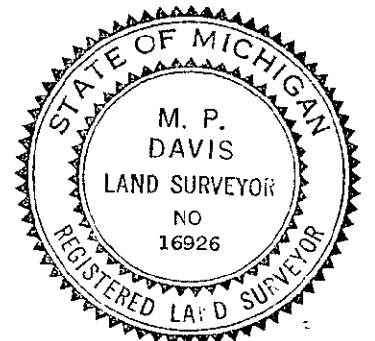

**C. Description of monument for corner and accessories established to perpetuate locating the position of the corner:**

- D-9 REPLACED EXISTING IRON PIN W/A 5/8" X 18" REBAR W/A 3-1/4" CAP STAMPED TO IDENTIFY CORNER POSITION.  

POWER POLE	SIGN POST	SE COR OF CONC PATIO	2" GALV STREET SIGN POST
N56°E	WEST	N47°W	S28°E EAST
36.18' (TO FACE)	5.65' (TO FACE)	38.58'	66.90'
- E-9 SET BERNTSEN AINB30 ALUMN. MON. W/ A 3-1/4" ALUMINUM CAP STAMPED TO IDENTIFY THE CORNER POSITION OVER THE EXISTING IRON PIPE.  

CEDAR 8"	CEDAR 5"	W.PINE 22"	CEDAR 9"	ALUMINUM SIGN POST
N50°W	N54°E	S42°E	S68°W	SOUTH
105.00'	57.06'	48.33'	71.40'	3.00'(TO FACE)

NOTE: BEARINGS TO REFERENCE OBJECTS ARE MAGNETIC-DISTANCES ARE TO A MEASURING NAIL IN THE CENTER OF THE OBJECT UNLESS NOTED OTHERWISE:

Signed by M.P. Davis Date 10/10/93  
 Surveyor's Michigan License No. 16926