

**SURVEY &  
REMONUMENTATION**

DEC 07 1993

COMMISSION

Approved By Delta County  
Land Survey Remonumentation  
Peer Group Under Act 345 Of  
P.A. Of 1990 On November 30, 1993

*Robert Belwelling*  
Chairman

**LAND CORNER RECORDATION CERTIFICATE**  
Filing Requirement of Act 74, Mich. P.A. 1970

DELTA COUNTY

For corners in

DELTA  
(County)

Located In:

Corner Code ##

- |                                       |                         |           |
|---------------------------------------|-------------------------|-----------|
| 1. Public Land Survey                 | T 39 N R23 W            | G-1 & F-3 |
|                                       | T _____ R _____         | _____     |
|                                       | T _____ R _____         | _____     |
|                                       | T _____ R _____         | _____     |
| 2. Property Controlling<br>In Section | S _____ T _____ R _____ | _____     |
|                                       | S _____ T _____ R _____ | _____     |
| 3. Miscellaneous<br>Property in Sec.  | S _____ T _____ R _____ | _____     |
|                                       | S _____ T _____ R _____ | _____     |

LIBER 7 PAGE 334

93 DEC -2 AM 9:00

*William C. Thoren*  
REGISTER OF DEEDS

Register of Deeds Stamp & File Number

4. Lot No. \_\_\_\_\_, Recorded Plat \_\_\_\_\_  
5. Private Claims \_\_\_\_\_  
G-1 [NW COR SEC 3] F-3 [1/4 COR COMMON TO SEC'S 4/9]

A	B	C	D	E	F	G	H	I	J	K	L	M
2	6	5	4	3	2	1						
3												
4	7	8	9	10	11	12						
5												
6	18	17	16	15	14	13						
7												
8	19	20	21	22	23	24						
9												
10	30	29	28	27	26	25						
11												
12	31	32	33	34	35	36						
13												

I, M. P. DAVIS, in a field survey on AUGUST, 19 93, do hereby certify that under requirements of P.A. 74, Michigan P.A. of 1970, the corner points mentioned in lines 1 and 2 above were in conformance with regulations and rules therefore as required in the current manual of survey instructions of the United States Department of the Interior, Bureau of Land Management or by a decree of a Court of Law and/or that the corner points mentioned in lines 3, 4 and 5 above were in conformance with the rules of the Michigan Board of Land Surveyors or by a Decree of a Court of Law; established, re-established, monumented, re-monumented, recovered, found as expressed below:

**NOTE: Not more than 4 corners, all in the same town and range, may be recorded on this certificate.**


A. Description of original monument and accessories and/or subsequent restoration:

- G-1 [NW COR SEC 3] WOOD POST - JOHN BURT - 1845 (CEDAR 22°-N12°E-36 LINKS) (CEDAR 10°-N7°W-7 LINKS)  
A. MERRYWEATHER - WOOD POST IN PLACE - 1846 (BIRCH 6°-S50°W-12 LINKS) (CEDAR 8°-S66°E-14 LINKS)  
D.A. BROTHEERTON - 1910 - ID FROM ORIGINALS - NEW BT'S W. BIRCH N50°E-21.12' 7 S50°W-25.6'  
M.S. McNABB - 1942 - STAKE IN PLACE - CEDAR 15°-N85°W-41'  
N. DAVIS - 1974 - SET 3/4" X 18" I.P. W/A SURVEY CAP - L.C.R.'S. IN LIBER 1 PAGE 417

- F-3 [1/4 COR COMMON TO SEC'S 4/9] WOOD POST - A. MERRYWEATHER - 1846 (BEECH 8°-S10°W-7 LINKS) (BEECH 14°-N30°E-18 LINKS)  
D.A. BROTHEERTON - 1912 - ID FROM ORIGINALS - FENCE POSTS - S22°50'E-24.2' -- N19°40'W-23.75' -- S11°40'W-24.4'  
M.S. McNABB - 1925 - IRON BOLT IN HWY. - FENCE POSTS -N33°W-27.7' -- N38°E-28.4'  
G. CARLSON - 1989 - FOUND IRON BOLT - L.C.R.'S. IN LIBER 6 PAGE 310

B. Description of corner evidence found and/or method applied in restoring or reestablishing corner:

- G-1 [NW COR SEC 3] FOUND, 14" BELOW ROAD SURFACE, I.P. AS DESCRIBED IN L.C.R.'S IN LIBER 1 PAGE 417 - ACCEPTED AS A CAREFUL & FAITHFUL PERPETUATION OF THE POSITION OF THE ORIGINAL CORNER  
F-3 [1/4 COR COMMON TO SEC'S 4/9] FOUND IRON BOLT AS DESCRIBED IN L.C.R.'S. IN LIBER 6 PAGE 310 ACCEPTED AS A CAREFUL & FAITHFUL PERPETUATION OF THE POSITION OF THE ORIGINAL CORNER

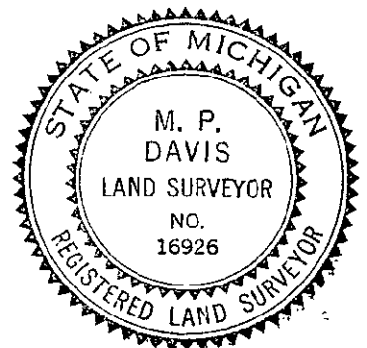

C. Description of monument for corner and accessories established to perpetuate locating the position of the corner:

- G-1 RAISED TO 4" BELOW ROAD SURFACE W/A 5/8" X 18" REBAR W/A ALUMN CAP STAMPED TO ID THE COR POSITION  
CEDAR 5" CEDAR 5" TAMARACK 7" CEDAR 22" (OLD BT) SURVEY MONUMENT SIGN POST  
N30°W N70°E S55°E N85°W EAST  
63.70' 52.55' 59.05' 41.85' 23.58' (TO FACE)

- F-3 SET, OVER EXISTING MONUMENT, A 5/8" X 18" REBAR W/A ALUMN CAP STAMPED TO ID THE COR POSITION & RAISED TO RD SURFACE W/A MON BOX CHISELED CUT ON CMP X-PIPE SW COR CONC TELE PAD ANCHOR POLE SURVEY MONUMENT SIGN POST  
N36°W N37°E S59°E SOUTH  
35.75' 54.37' 75.52' 26.78' (TO FACE)

NOTE: BEARINGS TO REFERENCE OBJECTS ARE MAGNETIC & DISTANCES ARE TO A NAIL IN THE CENTER OF THE OBJECT UNLESS NOTED OTHERWISE

Signed by M. P. Davis Date 11/15/93  
Surveyor's Michigan License No. 16926