

Robert Schmeling
 Chairman

LAND CORNER RECORDATION CERTIFICATE
 Filing Requirement of Act 74, Mich. P.A. 1970

For corners in
DELTA
 (County)

Located In: Corner Code ##

- | | | |
|------------------------------------|-------------------------|------------------|
| 1. Public Land Survey | T 39 N R 23 W | C-8 & <u>B-9</u> |
| | T _____ R _____ | _____ |
| | T _____ R _____ | _____ |
| | T _____ R _____ | _____ |
| 2. Property Controlling in Section | S _____ T _____ R _____ | _____ |
| | S _____ T _____ R _____ | _____ |
| 3. Miscellaneous Property in Sec. | S _____ T _____ R _____ | _____ |
| | S _____ T _____ R _____ | _____ |

MAY 13 1994

Recorded _____
 9:00 at _____ o'clock AM in Liber 7 Page 392
William C. Thomas Reg. of Deeds.
 Delta County, Michigan
 Register of Deeds Stamp & File Number

4. Lot No. _____, Recorded Plat _____
 5. Private Claims _____
 C-8 [W1/4 COR SEC 20] F-9 [W1/4 COR SEC 28]

	A	B	C	D	E	F	G	H	I	J	K	L	M
2	6		5		4		3		2		1		
3													
4	7		8		9		10		11		12		
5													
6	18		17		16		15		14		13		
7													
8	19		20		21		22		23		24		
9													
10	30		29		28		27		26		25		
11													
12	31		32		33		34		35		36		
13													


I, M.P. DAVIS, in a field survey on APRIL, 19 94, do hereby certify that under requirements of P.A. 74, Michigan P.A. of 1970, the corner points mentioned in lines 1 and 2 above were in conformance with regulations and rules therefore as required in the current manual of survey instructions of the United States Department of the Interior, Bureau of Land Management or by a decree of a Court of Law and/or that the corner points mentioned in lines 3, 4 and 5 above were in conformance with the rules of the Michigan Board of Land Surveyors or by a Decree of a Court of Law; established, re-established, monumented, re-monumented, recovered, found as expressed below:

NOTE: Not more than 4 corners, all in the same town and range, may be recorded on this certificate.

- A. Description of original monument and accessories and/or subsequent restoration:
 C-8 [W1/4 COR SEC 20] WOOD POST-1846-A.MERRYWEATHER D.S. (CEDAR 12"-S15°W-04 LINKS) (CEDAR 14"-N24°E-15 LINKS)
 M.S.McNABB - 1914 - ID COR POSITION DURING ROAD ALIGNMENT SURVEY FOR WELLS TWP. BY "STAKE IN PLACE & BOTH ORIGINALS"
 F-9 [N1/4 COR SEC 28] WOOD POST-1846-A. MERRYWEATHER, D.S. (HEMLOCK 10"-SOUTH-03 LINKS) (HEMLOCK 06"-N04°W-09 LINKS)
 NO RECORD EVIDENCE OF CORNER RECOVERY OR SUBSEQUENT MONUMENTATION

- B. Description of corner evidence found and/or method applied in restoring or reestablishing corner:
 C-8 [W1/4 COR SEC 20] FOUND IRON PIN 26" BELOW ROAD SURFACE. THIS POSITION CHECKS WELL WITH McNABB'S DISTANCES N & S TO THE SEC CORNERS & THE DEFLECTION ANGLE AT THE MONUMENT CHECKS WITH THAT SEOWN IN McNABB'S RECORDS. ACCEPTED EXISTING MONUMENT AS BEING A CAREFUL AND FAITHFUL PERPETUATION OF THE POSITION OF THE ORIGINAL CORNER.

F-9 [N1/4 COR SEC 28] NO CORNER EVIDENCE FOUND. ESTABLISHED CORNER POSITION AT MIDPOINT BETWEEN BETWEEN SEC CORNERS EAST & WEST.

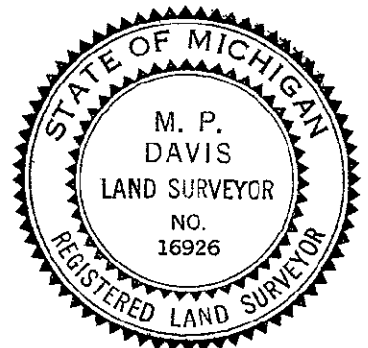

- C. Description of monument for corner and accessories established to perpetuate locating the position of the corner:
 C-8 SET, OVER EXISTING MON. A 5/8" X 18" REBAR W/A 3-1/4" ALUMN CAP STAMPED TO ID CORNER POSITION & RAISED TO RD SURFACE W/A MON BO:
 CEDAR 10" CEDAR 8" SURVEY MONUMENT SIGN POST
 S20°E S30°W WEST
 101.90' 102.45' 18.50' (TO FACE)
 F-9 SET BERNTSEN A1NB30 ALUMN MONUMENT WITH THE CAP STAMPED TO ID THE CORNER POSITION
 WHITE PINE 09" HEMLOCK 08" WHITE PINE 10" WHITE PINE 10" SURVEY MONUMENT SIGN POST
 N28°W N33°E S45°E S82°W EAST
 5.97' 17.70' 31.87' 14.53' 2.57' (TO FACE)

NOTE: BEARINGS TO REFERENCE OBJECTS ARE MAGNETIC & DISTANCES ARE TO A NAIL W/A REFERENCE TAG, UNLESS NOTED OTHERWISE

Signed by M.P. Davis Date 5/6/94
 Surveyor's Michigan License No. 16926