

SURVEY & REMONUMENTATION

DEC 07 1993

COMMISSION

Approved By Delta County
Land Survey Remonumentation
Peer Group Under Act 345 Of
P.A. Of 1990 On December 30, 1993
Robert R. Laveling
Chairman

LAND CORNER RECORDATION CERTIFICATE
Filing Requirement of Act 74, Mich. P.A. 1970

For corners in
DELTA
(County)

Located In: Corner Code #/

- | | | |
|------------------------------------|-------------------------|-----------|
| 1. Public Land Survey | T 39 N R 23 W | H-5 & G-3 |
| | T _____ R _____ | _____ |
| | T _____ R _____ | _____ |
| | T _____ R _____ | _____ |
| 2. Property Controlling in Section | S _____ T _____ R _____ | _____ |
| | S _____ T _____ R _____ | _____ |
| 3. Miscellaneous Property in Sec. | S _____ T _____ R _____ | _____ |
| | S _____ T _____ R _____ | _____ |

DELTA COUNTY
LIBER 7 PAGE 306

93 DEC -2 AM 9:00

Wallace C. Hanson
REGISTER OF DEEDS
Register of Deeds Stamp & File Number

4. Lot No. _____, Recorded Plat _____
5. Private Claims _____
H-5 [1/4 COR COMMON TO SEC'S 10/15] G-3 [NW COR SEC 10]


A	B	C	D	E	F	G	H	I	J	K	L	M
2	6	5	4	3	2	1						
3												
4	7	8	9	10	11	12						
5												
6	18	17	16	15	14	13						
7												
8	19	20	21	22	23	24						
9												
10	30	29	28	27	26	25						
11												
12	31	32	33	34	35	36						
13												

I, M.P. DAVIS, in a field survey on AUGUST, 19 93, do hereby certify that under requirements of P.A. 74, Michigan P.A. of 1970, the corner points mentioned in lines 1 and 2 above were in conformance with regulations and rules therefore as required in the current manual of survey instructions of the United States Department of the Interior, Bureau of Land Management or by a decree of a Court of Law and/or that the corner points mentioned in lines 3, 4 and 5 above were in conformance with the rules of the Michigan Board of Land Surveyors or by a Decree of a Court of Law; established, re-established, monumented, re-monumented, recovered, found as expressed below:

NOTE: Not more than 4 corners, all in the same town and range, may be recorded on this certificate.

- A. Description of original monument and accessories and/or subsequent restoration:
H-5 [1/4 COR COMMON TO SEC'S 10/15] WOOD POST-A. MERRYWEATHER-1846 (BEECH 12"-S10°W-6 LINKS) (BEECH 14"-N10°W-19 LINKS)
M.S. McNabb-1936-IRON STAKE IN PLACE - SET 1/2 DISTANCE BETWEEN CORNERS PREVIOUS SURVEY - NO WIT'S NOTED
M. DAVIS - 1972 - FOUND IRON PIN IN PLACE - L.C.R'S. IN LIBER 1 PAGE 50
G-3 [NW COR SEC 10] WOOD POST - A. MERRYWEATHER - 1846 (HEMLOCK 12"-S40°E-7 LINKS) (HEMLOCK 10"-N70°W-19 LINKS)
C.E. BROTHERTON - 1884 - BOTH ORIGINALS - NO NEW WIT'S NOTED
G. CARLSON - 1989 - 1" IRON IN PLACE - L.C.R'S. IN LIBER 6 PAGE 307

- B. Description of corner evidence found and/or method applied in restoring or reestablishing corner:
H-5 [1/4 COR COMMON TO SEC'S 10/15] FOUND MONUMENT AS DESCRIBED IN L.C.R'S IN LIBER 1 PAGE 50
ACCEPTED EXISTING MONUMENT AS A CAREFUL & FAITHFUL REESTABLISHMENT OF THE POSITION OF THE ORIGINAL CORNER
G-3 [NW COR SEC 10] FOUND MONUMENT AS DESCRIBED IN L.C.R'S. IN LIBER 6 PAGE 307
ACCEPTED EXISTING MONUMENT AS A CAREFUL & FAITHFUL PERPETUATION OF THE POSITION OF THE ORIGINAL CORNER

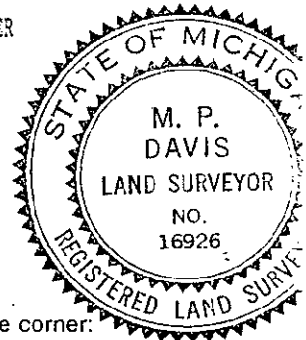

- C. Description of monument for corner and accessories established to perpetuate locating the position of the corner:
H-5 SET, OVER EXISTING MONUMENT, A 5/8" X 18" REBAR W/A ALUMN CAP STAMPED TO ID THE COR POSITION & RAISED TO RD SURFACE W/A MON BOX
MAPLE 10" W.PINE 10" POWER POLE RED PINE 17"
N54°W N38°E S63°E S55°W
81.62' 54.45' 84.75' 71.46'
G-3 SET, OVER EXISTING MONUMENT, A 5/8" X 18" REBAR W/A ALUMN CAP STAMPED TO ID THE COR POSITION & RAISED TO RD SURFACE W/A MON BOX
CHISELED CUT ON CMP X-PIPE CHISELED CUT ON CMP X-PIPE CHISELED CUT ON CMP X-PIPE POWER POLE
N45°W N43°E S32°W S40°E
44.20' 43.12' 65.55' 42.22'

NOTE: BEARINGS TO REFERENCE OBJECTS ARE MAGNETIC & DISTANCE ARE TO A NAIL IN THE CENTER OF THE OBJECT UNLESS NOTED OTHERWISE

Signed by M.P. Davis Date 10/30/93
Surveyor's Michigan License No. 16926