

Approved By Delta County  
 Land Survey Remonumentation  
 Peer Group Under Act 345 Of  
 P.A. Of 1990 On May 12, 1994  
*Robert Schmeling*  
 Acting Chairman

**LAND CORNER RECORDATION CERTIFICATE**  
 Filing Requirement of Act 74, Mich. P.A. 1970

For corners in  
DELTA  
 (County)

Located In: \_\_\_\_\_ Corner Code ##

1. Public Land Survey	T <u>39 N</u> R <u>23 W</u>	<u>G-6 &amp; (G-6)</u>
	T _____ R _____	_____
	T _____ R _____	_____
	T _____ R _____	_____
2. Property Controlling in Section	S _____ T _____ R _____	_____
	S _____ T _____ R _____	_____
3. Miscellaneous Property in Sec.	S _____ T _____ R _____	_____
	S _____ T _____ R _____	_____
4. Lot No. _____, Recorded Plat _____		
5. Private Claims _____		

G-6 [W1/4 COR SEC 15] G-9 [NW COR SEC 27]

MAY 13 1994

Recorded \_\_\_\_\_  
 at 9:00 o'clock AM In Liber 7 Page 394  
*William C. Thomas* Reg. of Deeds.  
 Delta County, Michigan  
 Register of Deeds Stamp & File Number


	A	B	C	D	E	F	G	H	I	J	K	L	M
2	6		5		4		3		2		1		
3													
4	7		8		9		10		11		12		
5													
6	18		17		16		15		14		13		
7													
8	19		20		21		22		23		24		
9													
10	30		29		28		27		26		25		
11													
12	31		32		33		34		35		36		
13													

I, M.P. DAVIS, in a field survey on MARCH, 19 94, do hereby certify that under requirements of P.A. 74, Michigan P.A. of 1970, the corner points mentioned in lines 1 and 2 above were in conformance with regulations and rules therefore as required in the current manual of survey instructions of the United States Department of the Interior, Bureau of Land Management or by a decree of a Court of Law and/or that the corner points mentioned in lines 3, 4 and 5 above were in conformance with the rules of the Michigan Board of Land Surveyors or by a Decree of a Court of Law, established, re-established, monumented, re-monumented, recovered, found as expressed below:

**NOTE: Not more than 4 corners, all in the same town and range, may be recorded on this certificate.**

- A. Description of original monument and accessories and/or subsequent restoration:  
 G-6 [W1/4 COR SEC 15] WOOD POST-1846-A. MERRYWEATHER D.S. (HEMLOCK 08"-N50°E-05 LINKS) (TAMERAC 14"-S70°W-22 LINKS) R.E.SCHMELING, RLS PLACED IP W/A BRASS CAP AT MIDPT BETWEEN SEC CORNERS - DATE UNKNOWN  
 G-9 [NW COR SEC 27] WOOD POST-1846-A. MERRYWEATHER, D.S. (HEMLOCK 10"-SOUTH-03 LINKS) (Y.PINE 30"-S70°E-13 LINKS) NO RECORD EVIDENCE OF CORNER RECOVERY OR SUBSEQUENT MONUMENTATION

- B. Description of corner evidence found and/or method applied in restoring or reestablishing corner:  
 G-6 [W1/4 COR SEC 15] NO EVIDENCE OF SCHMELING MONUMENT FOUND APPARENTLY DESTROYED DURING CONSTRUCTION OF N-S ELECTRICAL TRANSMISSION LINE. REESTABLISHED CORNER POSITION AT MIDPOINT BETWEEN SECTION CORNERS N & S.  
 G-9 [NW COR SEC 27] FOUND IN PLACE A SQUARED CEDAR POST PLACED BY PERSONS UNKNOWN. THIS MONUMENT CHECKS WELL WITH THE GLO STREAM K-ING TIES TO THE EAST & SOUTH. ACCEPTED EXISTING MONUMENT AS BEING A CAREFUL & FAITHFUL REESTABLISHMENT OF THE POSITION OF THE ORIGINAL CORNER.

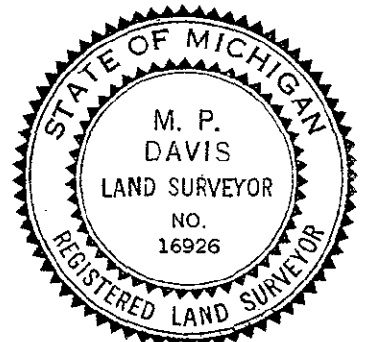

- C. Description of monument for corner and accessories established to perpetuate locating the position of the corner:  
 G-6 SET A BERNTSEN A1NB30 ALUMN MON WITH THE CAP STAMPED TO ID THE CORNER POSITION.  
 WHITE PINE 9"      POWER POLE      CEDAR 8"      SURVEY MONUMENT SIGN POST  
 N64°W              N37°E              S62°W              SOUTH  
 79.70'              74.13'              96.69'              3.00' (TO FACE)  
 G-9 REPLACE WOOD POST W/A BERNTSEN A1NB30 ALUMN MONUMENT WITH THE CAP STAMPED TO ID THE CORNER POSITION  
 MAPLE 18"      MAPLE 10"      MAPLE 13"      MAPLE 14"      SURVEY MONUMENT SIGN POST  
 N24°W              N28°E              S24°E              S09°W              EAST  
 5.92'              24.99'              13.80'              18.08'              2.10' (TO FACE)

NOTE: BEARINGS TO REFERENCE OBJECTS ARE MAGNETIC & DISTANCES ARE TO A NAIL W/A REFERENCE TAG, UNLESS NOTED OTHERWISE

Signed by M.P. Davis Date 5/6/94  
 Surveyor's Michigan License No. 16926