

Approved By Delta County
 Land Survey Remonumentation
 Peer Group Under Act 345 of
 P.A. Of 1990 On 12/22, 2000
Mark Schmaling
 Acting Chairman

LAND CORNER RECORDATION CERTIFICATE
 Filing Requirement of Act 74, Mich. P.A. 1970

For corners in

DELTA (County)	Located in:	Corner Code #
1. Public Land Survey	T 39 N R 23 W T 39 N R 23 W T R T R	D-05 I-02 ✓
2. Property Controlling in Section	S T R S T R	
3. Miscellaneous Property in Sec.	S T R S T R	

RECORDED 08 January 2001
 AT 9:00 O'CLOCK A.M.

LIBER 9 PAGE 250
Nancy G. Kolich
 DELTA COUNTY M. REG. OF DEEDS

Register of Deeds Stamp & File Number

D-05 [N1/4 COR SEC 17] I-02 [W1/4 COR SEC 2]

4. Lot No. _____, Recorded Plat _____
 5. Private Claims _____

I, M.P. DAVIS, in a field survey on DECEMBER, 2000 do hereby state that under requirements of P.A. 74, Michigan P.A. of 1970, the corner points mentioned in lines 1 and 2 above were in conformance with regulations and rules therefore as required in the current manual of survey instructions of the United States Department of the Interior, Bureau of Land Management or by a decree of a Court of Law and/or that the corner points mentioned in lines 3, 4 and 5 above were in conformance with the rules of the Michigan Board of Land Surveyors or by a Decree of a Court of Law; established, re-established, monumented, recovered, found as expressed below:

NOTE: Not more than 2 corners, all in the same town and range, may be recorded on this certificate.

	A	B	C	D	E	F	G	H	I	J	K	L	M
1													
2	6		5		4			3	●	2		1	
3													
4	7		8		9			10		11		12	
5				●									
6	10		17		16			15		14		13	
7													
8	19		20		21			22		23		24	
9													
10	30		29		28			27		26		25	
11													
12	31		32		33			34		35		36	
13													

A. Description of original monument and accessories and/or subsequent restoration:

D-05 [N1/4 COR SEC 17] A.MERRYWEATHER, D.S.-1846-WOOD POST (TAMARACK 12" S15°E 19 LINKS)(CEDAR 06" N10°E 16 LINKS) D.A.BROTHERTON-1908-"ORIGINALS GONE" - ESTABLISHED 1/2 DISTANCE BETWEEN CORNERS (NO WIT'S NOTED)

I-02 [W1/4 COR SEC 2] A.MERRYWEATHER, D.S.-1846-WOOD POST (HEMLOCK 13" S70°E 06 LINKS)(HEMLOCK 06" N45°W 26 LINKS) M.S.McNABB-1941- CORNER IN PLACE AT FENCE CORNER -NO WIT'S NOTED OR DESCRIPTION OF MONUMENT GIVEN M.DAVIS - 1974- L.1 OF LCR'S PAGE 417 - FOUND IN PLACE A 2" IRON PIPE AT A FENCE CORNER (MAPLE 8" S60°E 10.0') (MAPLE N07°E 65.45'. ALIGNMENT & DISTANCE CHECK WELL WITH THE RECORDS OF McNABB SOUTH TO THE FOUND 1/16 & SW SEC COR'S.

B. Description of corner evidence found and/or method applied in restoring or reestablishing corner:


D-05 [N1/4 COR SEC 17] NO CORNER EVIDENCE FOUND. REESTABLISHED THE CORNER POSITION AT THE MIDPOINT BETWEEN AND ON LINE WITH THE SECTION CORNERS 1/2 MILE TO THE EAST & WEST, AS PER THE 1908 RECORDS OF D.A. BROTHERTON.

I-02 [W1/4 COR SEC 2] FOUND IN PLACE, AT A FENCE CORNER, A 2" IRON PIPE. ID SAME AS THAT HAVING BEEN RECOVERED IN 1974 BY MYSELF. ID EXISTING MONUMENT FROM THE 1974 MAPLE BT TO THE NE WHICH IS STILL GREEN. ACCEPTED EXISTING MONUMENT AS BEING THE BEST AVAILABLE EVIDENCE AS TO THE LOCATION OF THE POSITION OF THE ORIGINAL CORNER.

C. Description of monument for corner and accessories established to perpetuate locating the position of the corner:

D-05 SET A BERNTSEN A1NB30 ALUM MONUMENT WITH THE CAP STAMPED TO ID THE CORNER POSITION.
 CEDAR 08" CEDAR 10" CEDAR 09" TAMARACK 13"
 N35°W N44°E S48°E S85°W
 14.12' 17.38' 19.61' 11.23'

I-02 SET, OVER EXISTING MONUMENT, A BERNTSEN A1NB30 ALUM MONUMENT WITH THE CAP STAMPED TO ID THE CORNER POSITION.
 BALSAM 04" MAPLE 13 MAPLE 08" SURVEY MONUMENT SIGN POST
 N37°W S48°W S61°E N27°E
 03.71' 09.82' 35.24' 4.53' (TO FACE)

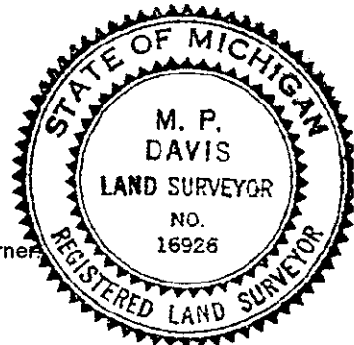

NOTE: BEARINGS TO REFERENCE OBJECTS ARE MAGNETIC-DISTANCES ARE TO A NAIL W/A DELTA COUNTY REFERENCE TAG, UNLESS OTHERWISE NOTED.

Signed by M.P. Davis
 Surveyor's Michigan License No. 16926

Date 12/23/00