

**SURVEY & REMONUMENTATION**

DEC 07 1993

COMMISSION

**LAND CORNER RECORDATION CERTIFICATE**  
Filing Requirement of Act 74, Mich. P.A. 1970

Approved by Delta County  
Land Survey Remonumentation  
Peer Group Under Act 345 Of  
P.A. Of 1990 On November 3, 1993

*Robert DeKoning*  
Acting Chairman

DELTA COUNTY

LIBER 7 PAGE 344

93 DEC -2 AM 9:00

*Walter A. Wilson*  
REGISTER OF DEEDS

Register of Deeds Stamp & File Number

For corners in

DELTA (County)	Located In:	Corner Code #
1. Public Land Survey	T 39 N R 23 W	B-13 & I-6
	T _____ R _____	_____
	T _____ R _____	_____
	T _____ R _____	_____
2. Property Controlling in Section	S _____ T _____ R _____	_____
	S _____ T _____ R _____	_____
3. Miscellaneous Property in Sec.	S _____ T _____ R _____	_____
	S _____ T _____ R _____	_____

4. Lot No. \_\_\_\_\_, Recorded Plat \_\_\_\_\_  
5. Private Claims \_\_\_\_\_  
B-13 [S1/4 COR SEC 31] I-6 [1/4 COR COMMON TO SEC'S 15/14]


I, M.P. DAVIS, in a field survey on MAY, 19 93, do hereby certify that under requirements of P.A. 74, Michigan P.A. of 1970, the corner points mentioned in lines 1 and 2 above were in conformance with regulations and rules therefore as required in the current manual of survey instructions of the United States Department of the Interior, Bureau of Land Management or by a decree of a Court of Law and/or that the corner points mentioned in lines 3, 4 and 5 above were in conformance with the rules of the Michigan Board of Land Surveyors or by a Decree of a Court of Law; established, re-established, monumented, re-monumented, recovered, found as expressed below:

**NOTE: Not more than 4 corners, all in the same town and range, may be recorded on this certificate.**

	A	B	C	D	E	F	G	H	I	J	K	L	M
2	6	5	4	3	2	1							
3													
4	7	3	9	10	11	12							
5													
6	18	17	16	15	14	13							
7													
8	19	20	21	22	23	24							
9													
10	30	29	28	27	26	25							
11													
12	31	32	33	34	35	36							
13													

- A. Description of original monument and accessories and/or subsequent restoration:  
 B-13 [S1/4 COR SEC 31] WOOD POST - JOHN BURT D.S. - 1844 - (SUGAR 10°-N8°W-14 LINKS) (SUGAR 5°-N52°E-29 LINKS)  
 C.E. BROTHERTON - 1882 - IDENTIFIED FROM ORIGINALS - NO NEW WIT'S NOTED  
 M.S. McNABB - 1919 - IDENTIFIED FROM BOTH ORIGINALS - NO NEW WIT'S NOTED  
 M.S. McNABB - 1935 - SET IRON BOLT - BIRCH 4°-S86°W-12'  
 I-6 [1/4 COR COMMON TO SEC'S 15/14] WOOD POST - A. MERRYWEATHER D.S. - 1846 - (HEMLOCK 10°-NORTH-14 LINKS) (BIRCH 5°-S25°W-12 LINKS)  
 M.S. McNABB - 1938 - STAKE IN PLACE WITH SURVEYOR'S SCRIBE - CLAIMED BY RESIDENCES TO HAVE BEEN SET FROM ORIGINALS - DROVE IRON CEDAR STUMP 15°-S29°E-27' -- CEDAR STUMP 20°-N12°E-45'

- B. Description of corner evidence found and/or method applied in restoring or reestablishing corner:  
 B-13 [S1/4 COR SEC 31] - FOUND McNABB'S IRON BOLT AT JCT OF FENCE LINE N & E  
 ACCEPTED EXISTING MONUMENT AS A CAREFUL & FAITHFUL PERPETUATION OF THE POSITION OF THE ORIGINAL CORNER  
 I-6 [1/4 COR COMMON TO SEC'S 15/14] FOUND McNABB'S 1938 IRON STAKE IN PLACE AS INDICATED BY RD IMPROVEMENTS, OCCUPATION & MEASUREMENTS TO ADJOINING CORNERS  
 ACCEPTED EXISTING MONUMENT AS A CAREFUL & FAITHFUL PERPETUATION OF THE POSITION OF THE ORIGINAL CORNER

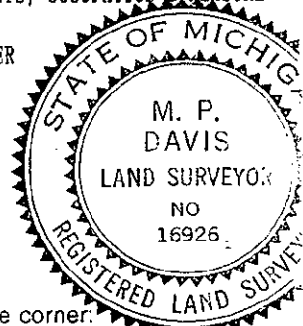

- C. Description of monument for corner and accessories established to perpetuate locating the position of the corner:  
 B-13 REPLACED IRON BOLT W/A 4" X 4" X 36" CONC MONUMENT W/A BRASS CAP STAMPED TO ID THE COR POSITION - PLACED 5' BELOW GROUND  

MAPLE 8"	MAPLE 12"	MAPLE 14"	SURVEY MONUMENT SIGN POST
N88°E	S10°E	S63°E	NORTH
8.07'	70.62'	33.93'	3.38' (TO FACE)

 I-6 SET, OVER EXISTING IRON, A 5/8" X 18" REBAR W/A ALUMN CAP STAMPED TO ID THE COR POSITION & RAISED TO RD SURFACE W/A MON BOX  

CEDAR 5"	MAPLE 10"	SE COR HOUSE
N18°E	S53°W	N36°W
31.00'	84.10'	83.65'

NOTE: BEARINGS TO REFERENCE OBJECTS ARE MAGNETIC & DISTANCES ARE TO A NAIL IN THE CENTER OF THE OBJECT UNLESS NOTED OTHERWISE

Signed by M.P. Davis Date 11/15/93  
 Surveyor's Michigan License No. 16926