

*Robert Schunberg*  
Acting Chairman

**LAND CORNER RECORDATION CERTIFICATE**  
Filing Requirement of Act 74, Mich. P.A. 1970

For corners in

<u>DELTA</u> (County)	Located In:	Corner Code ##
1. Public Land Survey	T <u>39</u> N R <u>23</u> W	<u>1-8 &amp; 1-9</u>
	T _____ R _____	_____
	T _____ R _____	_____
2. Property Controlling in Section	S _____ T _____ R _____	_____
	S _____ T _____ R _____	_____
3. Miscellaneous Property in Sec.	S _____ T _____ R _____	_____
	S _____ T _____ R _____	_____

MAY 13 1994

Recorded \_\_\_\_\_  
at 9:00 o'clock AM in Liber 7 Page 389  
*Walter C. Thorne* Reg. of Deeds.  
Delta County, Michigan  
Register of Deeds Stamp & File Number

4. Lot No. \_\_\_\_\_, Recorded Plat \_\_\_\_\_  
5. Private Claims \_\_\_\_\_  
I-8 [W1/4 COR SEC 23] I-9 [NW COR SEC 26]

	A	B	C	D	E	F	G	H	I	J	K	L	M
2	6	5	4	3	2	1							
3													
4	7	8	9	10	11	12							
5													
6	18	17	16	15	14	13							
7													
8	19	20	21	22	23	24							
9													
10	30	29	28	27	26	25							
11													
12	31	32	33	34	35	36							
13													

I, M. P. DAVIS, in a field survey on MARCH, 1994, do hereby certify that under requirements of P.A. 74, Michigan P.A. of 1970, the corner points mentioned in lines 1 and 2 above were in conformance with regulations and rules therefore as required in the current manual of survey instructions of the United States Department of the Interior, Bureau of Land Management or by a decree of a Court of Law and/or that the corner points mentioned in lines 3, 4 and 5 above were in conformance with the rules of the Michigan Board of Land Surveyors or by a Decree of a Court of Law; established, re-established, monumented, re-monumented, recovered, found as expressed below:


**NOTE: Not more than 4 corners, all in the same town and range, may be recorded on this certificate.**

A. Description of original monument and accessories and/or subsequent restoration:

- I-8 [W1/4 COR SEC 23] WOOD POST-1846-A. MERRYWEATHER D.S. (ASH 20"-S40°W-10 LINKS) (BALSAM 06"-N53°E-09 LINKS)  
CITY OF ESCANABA ENGINEER'S RECORDS INDICATE AN IRON PIPE IN PLACE - NO WI'S NOTED
- I-9 [NW COR SEC 26] WOOD POST-1846-A. MERRYWEATHER, D.S. (HEMLOCK 10"-N20°E-14 LINKS) (N. PINE 24"-S46°W-13 LINKS)  
NO RECORD EVIDENCE OF CORNER RECOVERY OR SUBSEQUENT MONUMENTATION

B. Description of corner evidence found and/or method applied in restoring or reestablishing corner:

- I-8 [W1/4 COR SEC 23] FOUND IRON PIPE IN PLACE - DISTANCES & ALIGNMENT NORTH TO EXISTING CORNERS COMPARES WELL WITH THE CITY ENGINEER'S RECORDS, ACCEPTED EXISTING MONUMENT AS A CAREFUL & FAITHFUL REESTABLISHMENT OF THE POSITION OF THE ORIGINAL CORNER.
- I-9 [NW COR SEC 26] ESTABLISHED TEMP COR POSITION FROM PROMINENT GLO TERRAIN CALLS N-S & E-W, MEASUREMENTS TO EXISTING CORNERS N, S, E & W FROM THIS POSITION DID NOT COMPARE WELL WITH THE GLO DISTANCES, IT WAS THERE FOR DETERMINED TO ESTABLISH THE NEW COR POSITION BY DOUBLE PROPORTIONATE MEASUREMENT BETWEEN EXISTING COR'S 1/2 MILE N, S & W & 1 MILE EAST AS BEING THE BEST REPRESENTATIVE POSITION OF THE ORIGINAL CORNER.

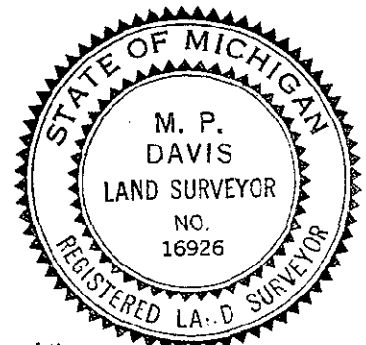

C. Description of monument for corner and accessories established to perpetuate locating the position of the corner:

- I-8 REPLACED EXISTING I.P W/A BERNTSEN A1NB30 ALUMN MON WITH THE CAP STAMPED TO ID THE CORNER POSITION.
- |        |           |        |           |                           |
|--------|-----------|--------|-----------|---------------------------|
| ASH 6" | MAPLE 10" | ASH 9" | CEDAR 10" | SURVEY MONUMENT SIGN POST |
| N43°W  | N28°E     | S61°E  | S27°W     | WEST                      |
| 6.29'  | 11.48'    | 10.53' | 26.06'    | 2.30' (TO FACE)           |
- I-9 SET BERNTSEN A1NB30 ALUMN MONUMENT WITH THE CAP STAMPED TO ID THE CORNER POSITION
- |             |                |               |          |                           |
|-------------|----------------|---------------|----------|---------------------------|
| RED PINE 6" | WHITE PINE 10" | WHITE PINE 9" | MAPLE 9" | SURVEY MONUMENT SIGN POST |
| N30°W       | N70°E          | S36°E         | S88°W    | SOUTH                     |
| 36.09'      | 12.23'         | 36.47'        | 5.51'    | 2.23' (TO FACE)           |

NOTE: BEARINGS TO REFERENCE OBJECTS ARE MAGNETIC & DISTANCES ARE TO A NAIL W/A REFERENCE TAG, UNLESS NOTED OTHERWISE

Signed by M. P. Davis Date 4/30/94

Surveyor's Michigan License No. 16926