

**SURVEY &  
REMONUMENTATION**

DEC 07 1993

COMMISSION

Approved by Delta County  
Land Survey Remonumentation  
Peer Group Under Act 345 Of  
P.A. Of 1990 On October 21, 1993

*Robert L. Schaefer*  
Acting Chairman

**LAND CORNER RECORDATION CERTIFICATE**  
Filing Requirement of Act 74, Mich. P.A. 1970

For corners in  
DELTA  
(County)

Located In: Corner Code #

- |                                    |                             |                |
|------------------------------------|-----------------------------|----------------|
| 1. Public Land Survey              | T <u>39 N</u> R <u>23 W</u> | <u>7-7</u> E-8 |
|                                    | T _____ R _____             | _____          |
|                                    | T _____ R _____             | _____          |
|                                    | T _____ R _____             | _____          |
| 2. Property Controlling in Section | S _____ T _____ R _____     | _____          |
|                                    | S _____ T _____ R _____     | _____          |
| 3. Miscellaneous Property in Sec.  | S _____ T _____ R _____     | _____          |
|                                    | S _____ T _____ R _____     | _____          |

DELTA COUNTY

LIBER 7 PAGE 320

93 DEC -2 AM 9:00

*William A. Thoren*  
REGISTER OF DEEDS

Register of Deeds Stamp & File Number

4. Lot No. \_\_\_\_\_, Recorded Plat \_\_\_\_\_  
5. Private Claims \_\_\_\_\_

1/4 COR'S COMMON TO SEC'S 14/23 & SEC'S 20/21

I, M.P. DAVIS, in a field survey on MAY & AUGUST, 19 93, do hereby certify that under requirements of P.A. 74, Michigan P.A. of 1970, the corner points mentioned in lines 1 and 2 above were in conformance with regulations and rules therefore as required in the current manual of survey instructions of the United States Department of the Interior, Bureau of Land Management or by a decree of a Court of Law and/or that the corner points mentioned in lines 3, 4 and 5 above were in conformance with the rules of the Michigan Board of Land Surveyors or by a Decree of a Court of Law, established, re-established, monumented, re-monumented, recovered, found as expressed below:


	A	B	C	D	E	F	G	H	I	J	K	L	M
2	6		5		4		3		2		1		
3													
4	7		8		9		10		11		12		
5													
6	18		17		16		15		14		13		
7													
8	19		20		21		22		23		24		
9													
10	30		29		28		27		26		25		
11													
12	31		32		33		34		35		36		
13													

**NOTE: Not more than 4 corners, all in the same town and range, may be recorded on this certificate.**

- A. Description of original monument and accessories and/or subsequent restoration:  
 J-7 [1/4 COR COMMON TO SEC'S 14/23] A.MERRYWEATHER-1846-WOOD POST - SPRUCE 4"-S10°W-3 LINKS - CEDAR 7"-N40°W-8 LINKS  
 M.S. McNABB-1941-WOOD STAKE-ESTABLISHED AT HALF DISTANCE BETWEEN CORNERS, PER ROAD SURVEY NOTES  
 W.BIRCH 5"-N35°W-24.25' - POPPLE 4"-S42°W-6.3'  
 E-8 [1/4 COR COMMON TO SEC'S 20/21] A.MERRYWESTHER-1846-WOOD POST - CEDAR 8"-N2°E-10 LINKS - SPRUCE 6"-S4°W-21 LINKS  
 M.S. McNABB-1934-NO ORIGINALS FOUND, ESTABLISHED HALF DISTANCE BETWEEN CORNERS - SET STAKE - NO WIT'S NOTED  
 M. DAVIS-1973-ESTABLISHED CORNER POSITION AT MIDPOINT BETWEEN SEC COR'S NORTH & SOUTH (REC'D LIBER 1, L.C.R.'s. ON PAGE 445)

- B. Description of corner evidence found and/or method applied in restoring or reestablishing corner:  
 J-7 NO EVIDENCE OF McNABB'S WOOD STAKE, AREA IS NOW OCCUPIED BY A LARGE OPEN LAND FILL, ESTABLISHED COR POSITION AT MIDPOINT BETWEEN SEC COR'S EAST & WEST

E-8 CORNER MONUMENT AS DESCRIBED IN LIBER 1 OF L.C.R.'s. ON PAGE 445 HAS BEEN DESTROYED IN RECENT C.R. CONSTRUCTION - RESET CORNER POSITION AS PER L.C.R.'s. AT MIDPOINT BETWEEN SECTION CORNERS NORTH & SOUTH

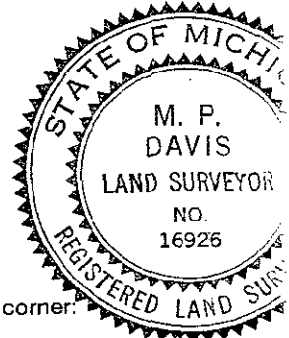

- C. Description of monument for corner and accessories established to perpetuate locating the position of the corner:  
 J-7 SET BERNTSEN A1NB30 ALUMN MONUMENT W/A 3-1/4" CAP STAMPED TO ID THE CORNER POSITION - COR IS IN A LARGE LAND FILL AREA NO WITS NEAR - SURVEY MONUMENT SIGN POST S45°W - 2.00' (TO FACE)  
 E-8 SET, INSIDE A MONUMENT BOX, A 5/8" X 18" REBAR W/A 3-1/4" ALUMN CAP STAMPED TO ID THE CORNER POSITION  
 CEDAR 6" CEDAR 5" CEDAR 7" SURVEY MONUMENT SIGN POST  
 N88°W N43°E S41°E EAST  
 44.19' 52.92' 51.22' 20.20' (TO FACE)

NOTE: BEARINGS TO REFERENCE OBJECTS ARE MAGNETIC & DISTANCE ARE TO A NAIL IN THE CENTER OF THE OBJECT UNLESS NOTED OTHERWISE

Signed by M.P. Davis Date 10/10/93  
 Surveyor's Michigan License No. 16926