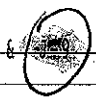


*Robert K. Klineberg*  
Acting Chairman

**LAND CORNER RECORDATION CERTIFICATE**  
Filing Requirement of Act 74, Mich. P.A. 1970

For corners in

| DELTA<br>(County)                  | Located In:             | Corner Code ##  |
|------------------------------------|-------------------------|---|
| 1. Public Land Survey              | T 39 N R 23 W           | K-9 &  |
|                                    | T _____ R _____         | _____   |
|                                    | T _____ R _____         | _____   |
|                                    | T _____ R _____         | _____   |
| 2. Property Controlling in Section | S _____ T _____ R _____ | _____   |
|                                    | S _____ T _____ R _____ | _____   |
| 3. Miscellaneous Property in Sec.  | S _____ T _____ R _____ | _____   |
|                                    | S _____ T _____ R _____ | _____   |

MAY 13 1994

Recorded \_\_\_\_\_  
9:00 AM 7 Page 391  
at \_\_\_\_\_ o'clock in Liber \_\_\_\_\_ Page \_\_\_\_\_  
*William C. Thomas* Reg. of Deeds.  
Delta County, Michigan  
Register of Deeds Stamp & File Number

4. Lot No. \_\_\_\_\_, Recorded Plat \_\_\_\_\_  
5. Private Claims \_\_\_\_\_  
K-9 [NW COR SEC 25] J-9 [N1/4 COR SEC 26]


|    | A  | B  | C  | D  | E  | F  | G | H | I | J | K | L | M |
|----|----|----|----|----|----|----|---|---|---|---|---|---|---|
| 2  | 6  | 5  | 4  | 3  | 2  | 1  |   |   |   |   |   |   |   |
| 3  |    |    |    |    |    |    |   |   |   |   |   |   |   |
| 4  | 7  | 8  | 9  | 10 | 11 | 12 |   |   |   |   |   |   |   |
| 5  |    |    |    |    |    |    |   |   |   |   |   |   |   |
| 6  | 18 | 17 | 16 | 15 | 14 | 13 |   |   |   |   |   |   |   |
| 7  |    |    |    |    |    |    |   |   |   |   |   |   |   |
| 8  | 19 | 20 | 21 | 22 | 23 | 24 |   |   |   |   |   |   |   |
| 9  |    |    |    |    |    |    |   |   |   |   |   |   |   |
| 10 | 30 | 29 | 28 | 27 | 26 | 25 |   |   |   |   |   |   |   |
| 11 |    |    |    |    |    |    |   |   |   |   |   |   |   |
| 12 | 31 | 32 | 33 | 34 | 35 | 36 |   |   |   |   |   |   |   |
| 13 |    |    |    |    |    |    |   |   |   |   |   |   |   |

I, M. P. DAVIS, in a field survey on MARCH, 19 94, do hereby certify that under requirements of P.A. 74, Michigan P.A. of 1970, the corner points mentioned in lines 1 and 2 above were in conformance with regulations and rules therefore as required in the current manual of survey instructions of the United States Department of the Interior, Bureau of Land Management or by a decree of a Court of Law and/or that the corner points mentioned in lines 3, 4 and 5 above were in conformance with the rules of the Michigan Board of Land Surveyors or by a Decree of a Court of Law; established, re-established, monumented, re-monumented, recovered, found as expressed below:

**NOTE: Not more than 4 corners, all in the same town and range, may be recorded on this certificate.**

- A. Description of original monument and accessories and/or subsequent restoration:  
K-9 [NW COR SEC 25] WOOD POST-1846-A. MERRYWEATHER D.S. (CEDAR 05°-S41°W-12 LINKS) (CEDAR 07°-N80°E-08 LINKS)  
CITY OF ESCANABA ENGINEER'S RECORDS INDICATE AN IRON PIPE IN PLACE - NO WIT'S NOTED  
J-9 [N1/4 COR SEC 26] WOOD POST-1846-A. MERRYWEATHER, D.S. (HEMLOCK 12°-N21°W-12 LINKS) (HEMLOCK 12°-S70°E-18 LINKS)  
NO RECORD EVIDENCE OF CORNER RECOVERY OR SUBSEQUENT MONUMENTATION

- B. Description of corner evidence found and/or method applied in restoring or reestablishing corner:  
K-9 [NW COR SEC 23] FOUND IRON PIPE IN PLACE - DISTANCES & ALIGNMENT TO ADJOINING CORNERS COMPARES WELL WITH THE CITY ENGINEER'S RECORDS, ACCEPTED EXISTING MONUMENT AS A CAREFUL & FAITHFUL REESTABLISHMENT OF THE POSITION OF THE ORIGINAL CORNER.  
J-9 [N1/4 COR SEC 26] ESTABLISHED COR POSITION AT MIDPOINT BETWEEN SECTION CORNERS EAST & WEST OF THE CORNER POSITION.

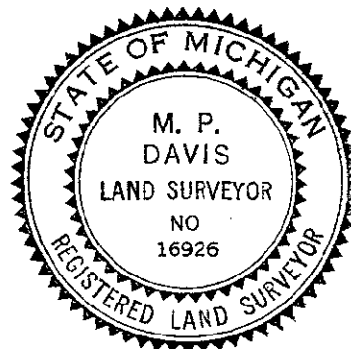

- C. Description of monument for corner and accessories established to perpetuate locating the position of the corner:  
K-9 REPLACED EXISTING I.P. W/A BERNTSEN AINB30 ALUMN MON WITH THE CAP STAMPED TO ID THE CORNER POSITION.  
SURVEY MONUMENT SIGN POST NOTE: CORNER POSITION IS LOCATED IN A DENSE TAG ALDER SWAMP NO WIT'S ARE AVAILABLE  
N45°W  
1.79' (TO FACE)  
J-9 SET BERNTSEN AINB30 ALUMN MONUMENT WITH THE CAP STAMPED TO ID THE CORNER POSITION  
RED PINE 14" WHITE PINE 15" WHITE PINE 14" RED PINE 14" SURVEY MONUMENT SIGN POST  
S48°W N52°W S10°E S77°E NORTH  
41.48' 12.58' 5.49' 30.34' 2.20' (TO FACE)

NOTE: BEARINGS TO REFERENCE OBJECTS ARE MAGNETIC & DISTANCES ARE TO A NAIL W/A REFERENCE TAG, UNLESS NOTED OTHERWISE

Signed by M.P. Davis Date 4/30/94  
Surveyor's Michigan License No. 16926