

SURVEY & REMONUMENTATION

DEC 07 1993

COMMISSION

LAND CORNER RECORDATION CERTIFICATE
Filing Requirement of Act 74, Mich. P.A. 1970

Approved By Delta County
 Land Survey Remonumentation
 Peer Group Under Act 345 Of
 P.A. Of 1990 On January 30, 1993

Mark Schmeling
 Chairman

DELTA COUNTY

LIBER 7 PAGE 331

93 DEC -2 AM 9:00

Wallace C. Thoman
 REGISTER OF DEEDS

Register of Deeds Stamp & File Number

For corners in	Located In:	Corner Code #/
DELTA (County)		
1. Public Land Survey	T 39 N R 23 W	<u>K-11 & K-12</u>
	T _____ R _____	
	T _____ R _____	
	T _____ R _____	
2. Property Controlling in Section	S _____ T _____ R _____	
	S _____ T _____ R _____	
3. Miscellaneous Property in Sec.	S _____ T _____ R _____	
	S _____ T _____ R _____	


4. Lot No. _____, Recorded Plat _____
 5. Private Claims
 K-11 [NW COR SEC 36] K-12 [1/4 COR COMMON TO SEC'S 35/36]

I, M.P. DAVIS, in a field survey on AUGUST, 19 93, do hereby certify that under requirements of P.A. 74, Michigan P.A. of 1970, the corner points mentioned in lines 1 and 2 above were in conformance with regulations and rules therefore as required in the current manual of survey instructions of the United States Department of the Interior, Bureau of Land Management or by a decree of a Court of Law and/or that the corner points mentioned in lines 3, 4 and 5 above were in conformance with the rules of the Michigan Board of Land Surveyors or by a Decree of a Court of Law; established, re-established, monumented, re-monumented, recovered, found as expressed below:

	A	B	C	D	E	F	G	H	I	J	K	L	M
2	6	5	4	3	2	1							
3													
4	7	8	9	10	11	12							
5													
6	18	17	16	15	14	13							
7													
8	19	20	21	22	23	24							
9													
10	30	29	28	27	26	25							
11													
12	31	32	33	34	35	36							
13													

NOTE: Not more than 4 corners, all in the same town and range, may be recorded on this certificate.

- A. Description of original monument and accessories and/or subsequent restoration:
- K-11 [NW COR SEC 36] WOOD POST - A. MERRYWEATHER - 1846 (TAMERAC 8°-S65'E-6 LINKS) (TAMERAC 7°-S73'W-16 LINKS)
 M.S. McNABB - 1919 - LARGE COR FENCE POST IN PLACE (POPLAR 14°-S80'W-78.80') (FENCE POST-SOUTH-18.4')
 M.S. McNABB - 1936 - CONC. MONUMENT IN PLACE - NO WIT'S NOTED
 BRIAN TAAVOLA - 1982 - 1' IRON PIN IN PLACE - L.C.R.'S IN LIBER 5 PAGE 106
 - K-12 [1/4 COR COMMON TO SEC'S 35/36] WOOD POST - A. MERRYWEATHER - 1846 (CEDAR 6°-S77'E-16 LINKS) (CEDAR 4°-WEST-7 LINKS)
 M.S. McNABB - 1936 - CONCRETE MONUMENT IN PLACE - NO WIT'S NOTED
 M. DAVIS - 1976 - SET 1-1/4" I.P. - RETRACEMENT OF McNABB'S 1936 E-W 1/4 LINE - NO WIT'S AVAILABLE
 G. CARLSON - 1978 - FOUND 1-1/4" I.P. AS PER L.C.R.'S IN LIBER 2 PAGE 266 NO WITS AVAILABLE
- B. Description of corner evidence found and/or method applied in restoring or reestablishing corner:
- K-11 [NW COR SEC 36] FOUND 1" IRON PIN AS PER L.C.R.'S IN LIBER 5 PAGE 106
 ACCEPTED CORNER MONUMENT AS BEING A CAREFUL & FAITHFUL REESTABLISHMENT OF THE POSITION OF THE ORIGINAL CORNER
 - K-12 [1/4 COR COMMON TO SEC'S 35/36] MONUMENT AS DESCRIBED IN L.C.R.'S IN LIBER 2 PAGE 266 HAS BEEN REMOVED - RESET BY RETRACEMENT OF AREA SURVEYS OF RECORD - ACCEPTED SAME AS BEING A CARE & FAITHFUL REESTABLISHMENT OF THE POSITION OF THE ORIGINAL CORNER
- C. Description of monument for corner and accessories established to perpetuate locating the position of the corner:
- K-11 SET, OVER THE EXISTING MONUMENT, A BERNTSEN AINB30 ALUMINUM MONUMENT W/A 3-14" CAP STAMPED TO ID THE CORNER POSITION SURVEY MONUMENT SIGN POST - S45'E - 3.47' (TO FACE) - CONC MON NORTH 100.0'
 THIS COR IS LOCATED ON THE EAST BANK OF THE WILLOW CREEK DRAIN - NO WIT'S ARE AVAILABLE
 - K-12 SET BERNTSEN AINB30 ALUMINUM MONUMENT W/A 3-1/4" CAP STAMPED TO ID THE COR POSITION SURVEY MONUMENT SIGN POST - N45'W - 3.37' (TO FACE)
 THIS COR IS LOCATED ON THE EAST BANK OF THE WILLOW CREEK DRAIN - NO WIT'S ARE AVAILABLE

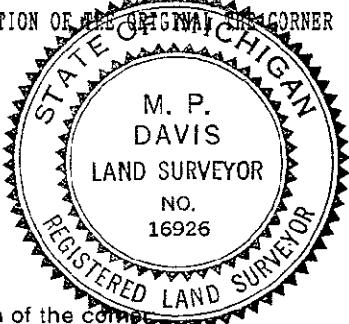

NOTE: BEARINGS TO REFERENCE OBJECTS ARE MAGNETIC & DISTANCE ARE TO A NAIL IN THE CENTER OF THE OBJECT UNLESS NOTED OTHERWISE

Signed by M.P. Davis Date 11/15/93

Surveyor's Michigan License No. 16926

LIBER 7 PAGE 331